



# Department of Transportation

## TRANSPORTATION NEWS

[www.dot.ny.gov](http://www.dot.ny.gov)

**For Immediate Release:**

Wednesday, May 27, 2026

**Contact:**

Heather Pillsworth | (845) 431-7911

Hudson Valley Region Press Office | [heather.pillsworth@dot.ny.gov](mailto:heather.pillsworth@dot.ny.gov)

### TRAVEL ADVISORY

#### **State Route 59 Expected to Close in Village of Spring Valley, Rockland County**

The New York State Department of Transportation advised Rockland County motorists today that State Route 59 will be closed to traffic between New Clarkstown Road and South Central Avenue in the Village of Spring Valley, beginning Wednesday, June 3, at 7 a.m., through the end of summer, to facilitate a bridge replacement, weather permitting.

Motorists should follow the posted detour.

#### **About the Department of Transportation**

It is the mission of the New York State Department of Transportation to provide a safe, reliable, equitable, and resilient transportation system that connects communities, enhances quality of life, protects the environment, and supports the economic well-being of New York State.

Lives are on the line; slow down and move over for highway workers!


For more information, find us on [Facebook](#), follow us on [X](#) or [Instagram](#), or visit our [website](#). For up-to-date travel information, call 511, visit [www.511NY.org](http://www.511NY.org) or download the free 511NY mobile app.

###

PROJECT MANAGER L. FERNANDEZ  
 CHECK C. BIANCHI  
 DRAFTING C. SARGEANT  
 CHECK C. SARGEANT  
 DESIGN C. BIANCHI  
 JOB MANAGER L. FERNANDEZ  
 DESIGN SUPERVISOR B. SIVAKUMAR

**LEGEND:**

- PRIMARY DETOUR ROUTE (NYS ROUTE 59)
- ... DETOUR ROUTE (SOUTH PASCACK ROAD)
- T — CONSTRUCTION SIGN, ITEM 619.01
- M4-9 M.U.T.C.D. SIGN I.D.
- ▨ ROADWAY CLOSURE AREA

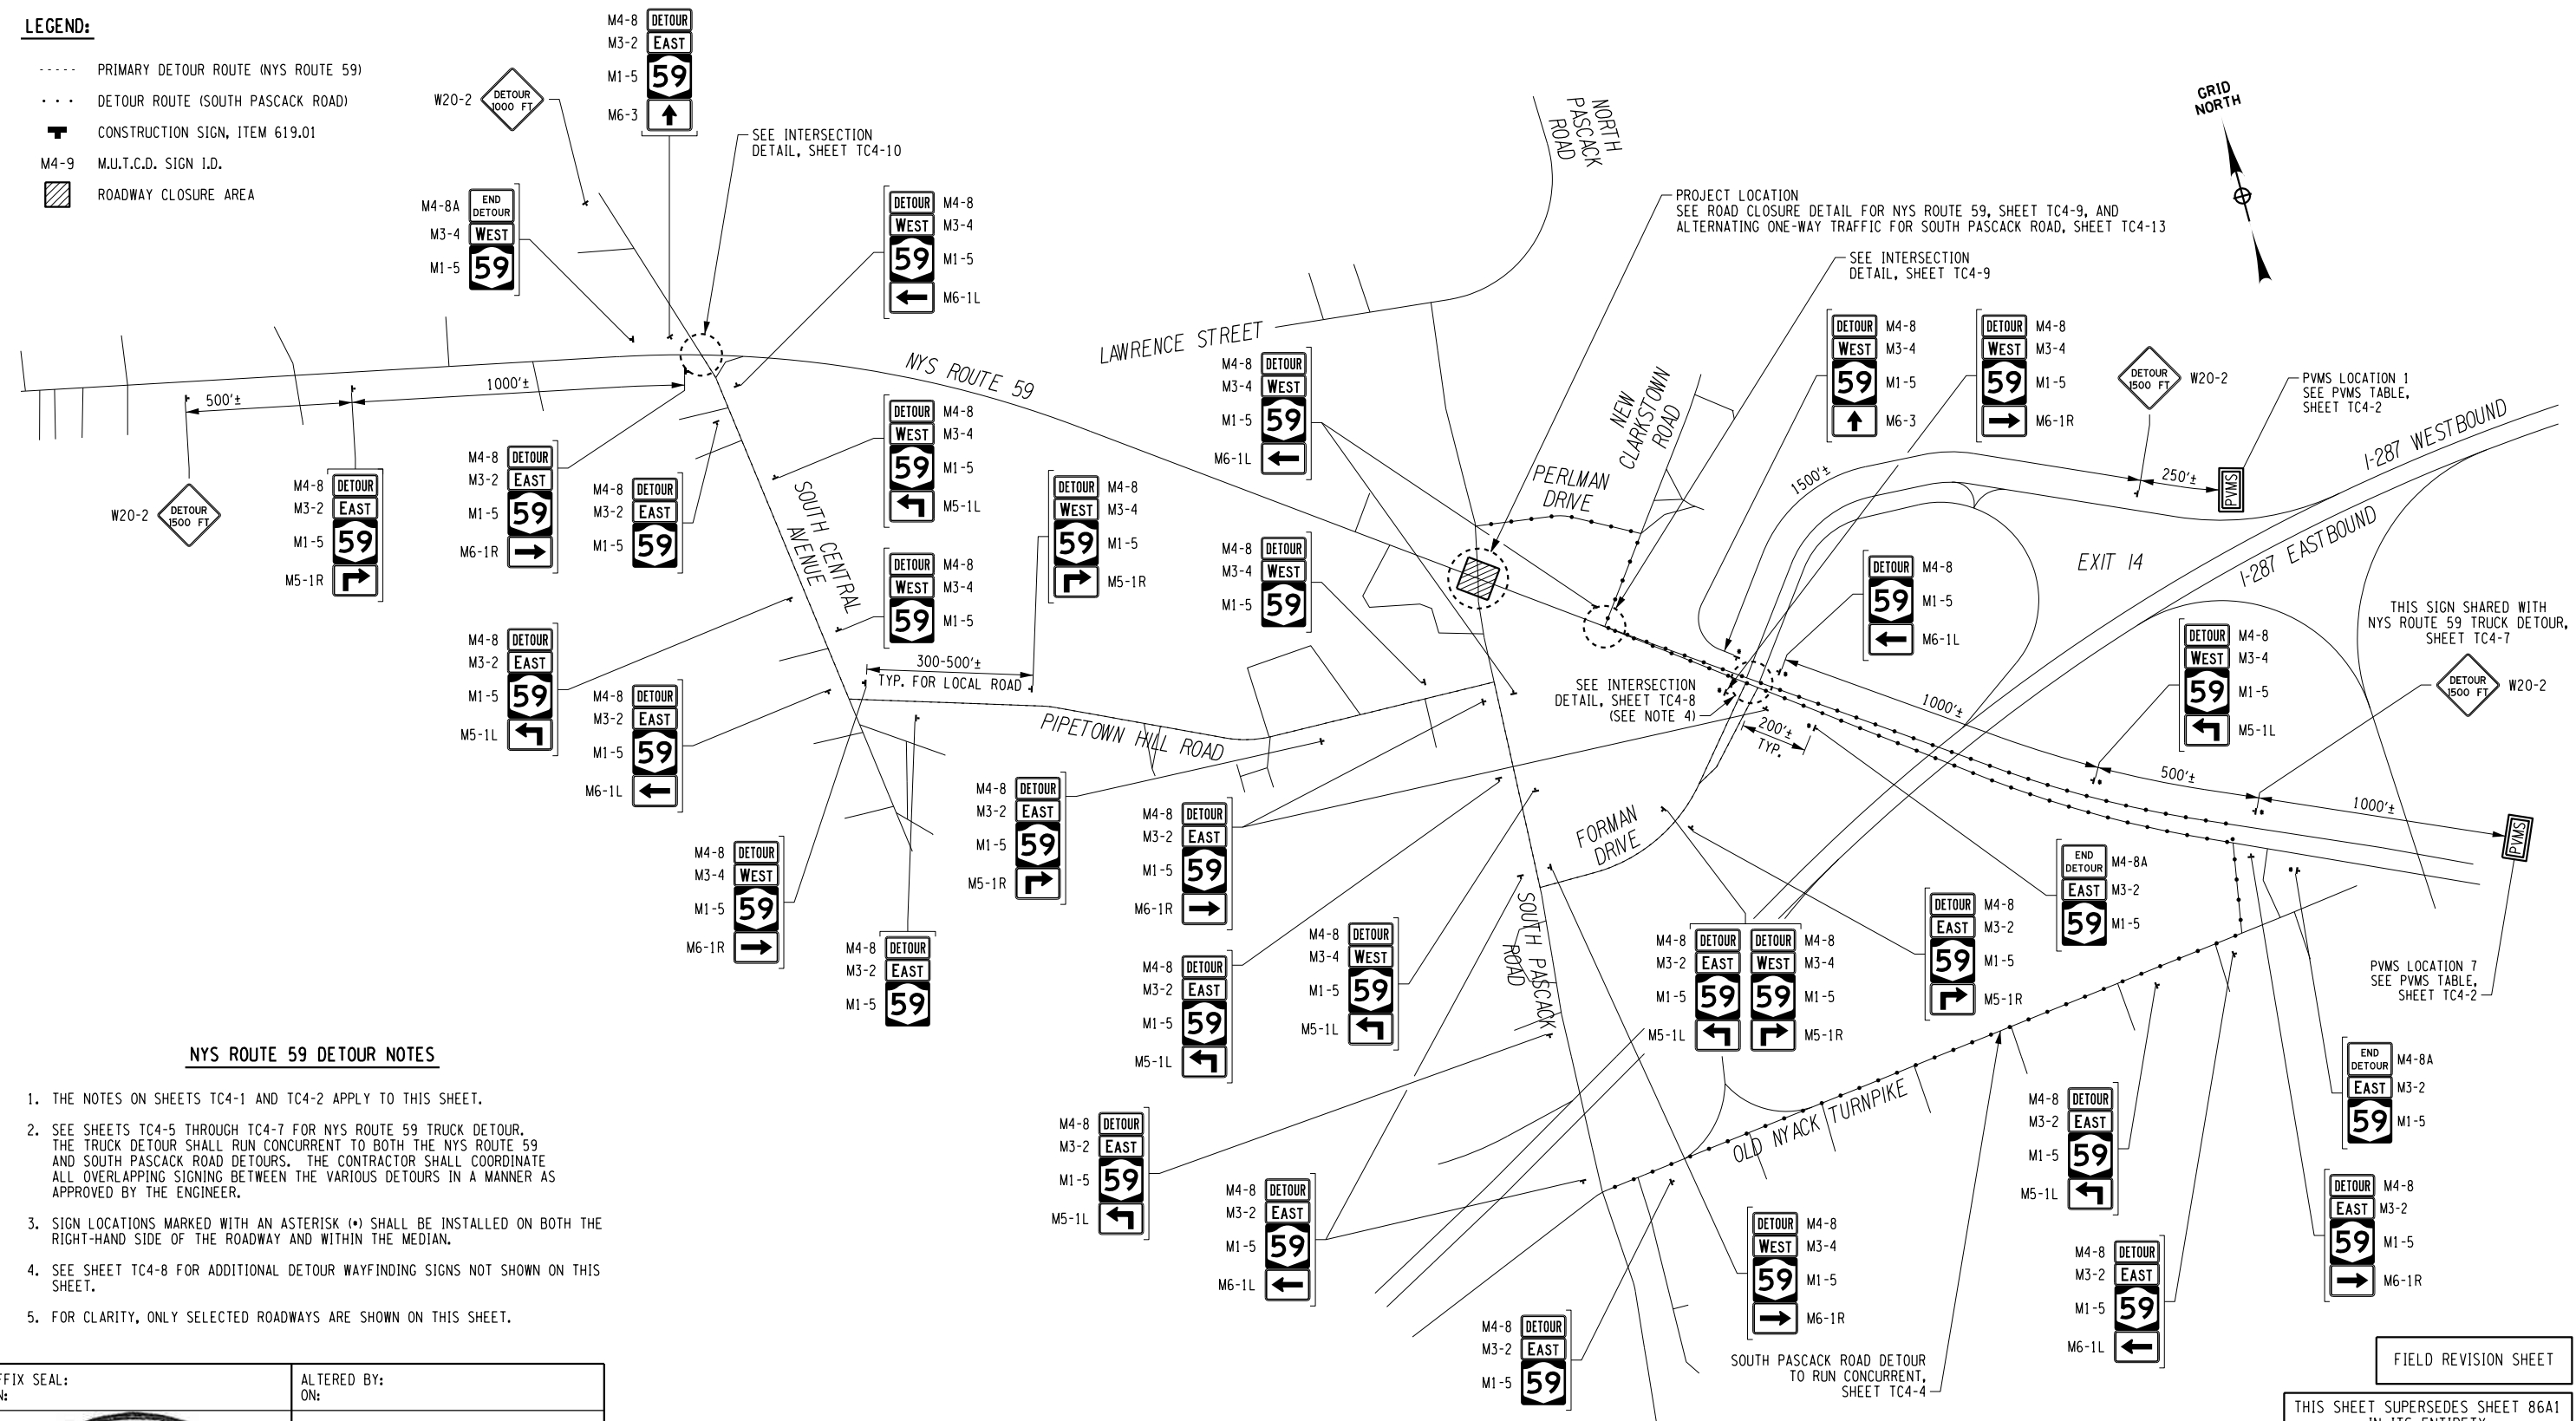

**NYS ROUTE 59 DETOUR NOTES**

1. THE NOTES ON SHEETS TC4-1 AND TC4-2 APPLY TO THIS SHEET.
2. SEE SHEETS TC4-5 THROUGH TC4-7 FOR NYS ROUTE 59 TRUCK DETOUR. THE TRUCK DETOUR SHALL RUN CONCURRENT TO BOTH THE NYS ROUTE 59 AND SOUTH PASCACK ROAD DETOURS. THE CONTRACTOR SHALL COORDINATE ALL OVERLAPPING SIGNING BETWEEN THE VARIOUS DETOURS IN A MANNER AS APPROVED BY THE ENGINEER.
3. SIGN LOCATIONS MARKED WITH AN ASTERISK (\*) SHALL BE INSTALLED ON BOTH THE RIGHT-HAND SIDE OF THE ROADWAY AND WITHIN THE MEDIAN.
4. SEE SHEET TC4-8 FOR ADDITIONAL DETOUR WAYFINDING SIGNS NOT SHOWN ON THIS SHEET.
5. FOR CLARITY, ONLY SELECTED ROADWAYS ARE SHOWN ON THIS SHEET.

AFFIX SEAL: ON: \_\_\_\_\_  
 ALTERED BY: ON: \_\_\_\_\_



AS-BUILT REVISIONS DESCRIPTION OF ALTERATIONS:	NYSOT SUPERSTRUCTURE REPLACEMENT, ASSIGNMENT 6	PIN 8813.69	BRIDGES 1027670	CULVERTS	ALL DIMENSIONS IN FT UNLESS OTHERWISE NOTED	CONTRACT NUMBER D265445
	RT-59 OVER S. PASCACK ROAD				DETOUR PLAN (SHEET 1 OF 5) (RT-59 OVER S. PASCACK ROAD)	DRAWING NO. TC4-3 SHEET NO. 86A1R1
	VILLAGE OF SPRING VALLEY AND TOWN OF CLARKSTOWN					
	COUNTY: ROCKLAND REGION: 8					

IT IS A VIOLATION OF LAW FOR ANY PERSON, UNLESS THEY ARE ACTING UNDER THE DIRECTION OF A LICENSED PROFESSIONAL ENGINEER, ARCHITECT, LANDSCAPE ARCHITECT, OR LAND SURVEYOR, TO ALTER AN ITEM IN ANY WAY. IF AN ITEM BEARING THE STAMP OF A LICENSED PROFESSIONAL IS ALTERED, THE ALTERING ENGINEER, ARCHITECT, LANDSCAPE ARCHITECT, OR LAND SURVEYOR SHALL STAMP THE DOCUMENT AND INCLUDE THE NOTATION "ALTERED BY" FOLLOWED BY THEIR SIGNATURE, THE DATE OF SUCH ALTERATION, AND A SPECIFIC DESCRIPTION OF THE ALTERATION.

NEW SHEET NUMBER: 86A1R1	DESCRIPTION: REFERENCE PASCACK DETOUR	DATE: MAY 14, 2026
--------------------------	---------------------------------------	--------------------




FILE NAME = \$FILENAME\$  
 DATE/TIME = \$DATE\$  
 USER = \$USERNAME\$

PROJECT MANAGER L. FERNANDEZ  
 CHECK C. BIANCHI  
 DRAFTING C. SARGEANT  
 CHECK C. SARGEANT  
 DESIGN C. BIANCHI  
 JOB MANAGER L. FERNANDEZ  
 DESIGN SUPERVISOR B. SIVAKUMAR

**LEGEND:**

- DETOUR ROUTE (NYS ROUTE 59)
- .... DETOUR ROUTE (SOUTH PASCACK ROAD)
- ▬ CONSTRUCTION SIGN, ITEM 619.01
- M4-9 M.U.T.C.D. SIGN I.D.
- ▨ ROADWAY CLOSURE AREA

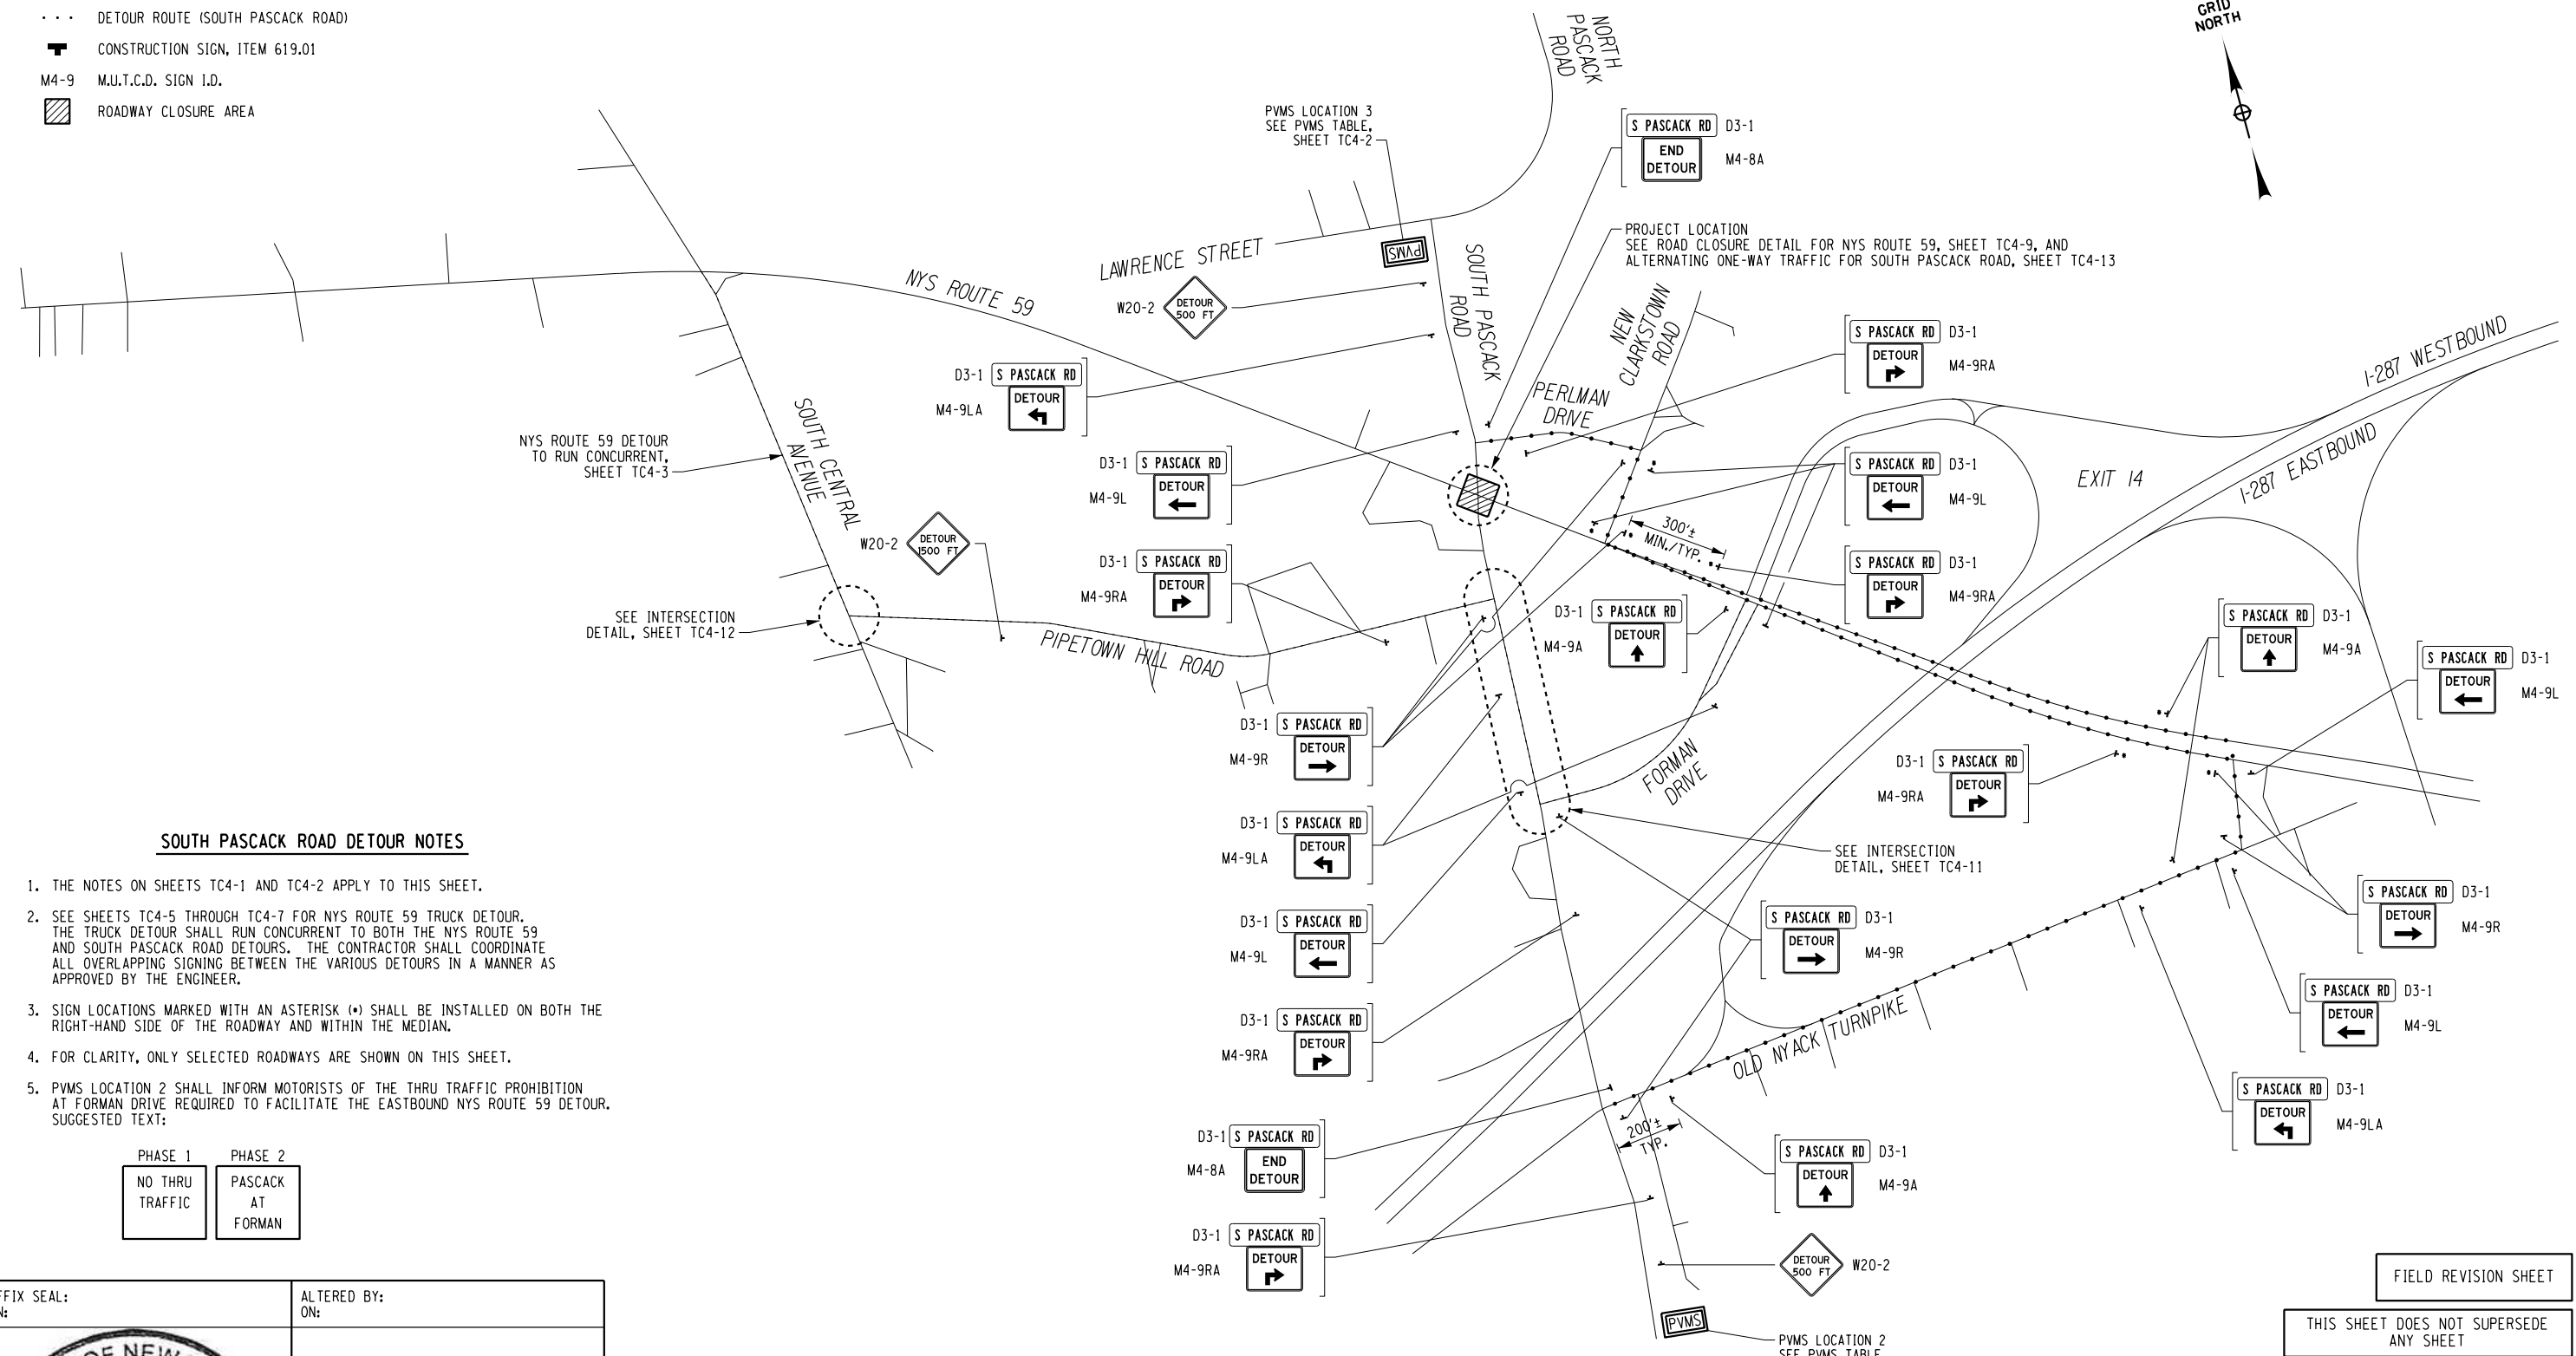

**SOUTH PASCACK ROAD DETOUR NOTES**

1. THE NOTES ON SHEETS TC4-1 AND TC4-2 APPLY TO THIS SHEET.
2. SEE SHEETS TC4-5 THROUGH TC4-7 FOR NYS ROUTE 59 TRUCK DETOUR. THE TRUCK DETOUR SHALL RUN CONCURRENT TO BOTH THE NYS ROUTE 59 AND SOUTH PASCACK ROAD DETOURS. THE CONTRACTOR SHALL COORDINATE ALL OVERLAPPING SIGNING BETWEEN THE VARIOUS DETOURS IN A MANNER AS APPROVED BY THE ENGINEER.
3. SIGN LOCATIONS MARKED WITH AN ASTERISK (\*) SHALL BE INSTALLED ON BOTH THE RIGHT-HAND SIDE OF THE ROADWAY AND WITHIN THE MEDIAN.
4. FOR CLARITY, ONLY SELECTED ROADWAYS ARE SHOWN ON THIS SHEET.
5. PVMS LOCATION 2 SHALL INFORM MOTORISTS OF THE THRU TRAFFIC PROHIBITION AT FORMAN DRIVE REQUIRED TO FACILITATE THE EASTBOUND NYS ROUTE 59 DETOUR. SUGGESTED TEXT:

PHASE 1 NO THRU TRAFFIC	PHASE 2 PASCACK AT FORMAN
----------------------------	------------------------------

AFFIX SEAL: ON: \_\_\_\_\_  
 ALTERED BY: ON: \_\_\_\_\_



AS-BUILT REVISIONS DESCRIPTION OF ALTERATIONS:	NYSOT SUPERSTRUCTURE REPLACEMENT, ASSIGNMENT 6	PIN 8813.69	BRIDGES 1027670	CULVERTS	ALL DIMENSIONS IN FT UNLESS OTHERWISE NOTED	CONTRACT NUMBER D265445
	RT-59 OVER S. PASCACK ROAD				DETOUR PLAN (SHEET 2 OF 5) (RT-59 OVER S. PASCACK ROAD)	DRAWING NO. TC4-4 SHEET NO. 86A2
	VILLAGE OF SPRING VALLEY AND TOWN OF CLARKSTOWN					
	COUNTY: ROCKLAND REGION: 8					

IT IS A VIOLATION OF LAW FOR ANY PERSON, UNLESS THEY ARE ACTING UNDER THE DIRECTION OF A LICENSED PROFESSIONAL ENGINEER, ARCHITECT, LANDSCAPE ARCHITECT, OR LAND SURVEYOR, TO ALTER AN ITEM IN ANY WAY. IF AN ITEM BEARING THE STAMP OF A LICENSED PROFESSIONAL IS ALTERED, THE ALTERING ENGINEER, ARCHITECT, LANDSCAPE ARCHITECT, OR LAND SURVEYOR SHALL STAMP THE DOCUMENT AND INCLUDE THE NOTATION "ALTERED BY" FOLLOWED BY THEIR SIGNATURE, THE DATE OF SUCH ALTERATION, AND A SPECIFIC DESCRIPTION OF THE ALTERATION.

FIELD REVISION SHEET

THIS SHEET DOES NOT SUPERSEDE ANY SHEET


NEW SHEET NUMBER: 86A2	DESCRIPTION: ADDED S PASCACK RD DETOUR	DATE: MAY 14, 2026
------------------------	--	--------------------



FILE NAME = \$FILENAME\$  
 DATE/TIME = \$DATE\$  
 USER = \$USERNAME\$

PROJECT MANAGER L. FERNANDEZ  
 CHECK C. BIANCHI  
 DRAFTING C. SARGEANT  
 CHECK C. SARGEANT  
 DESIGN C. BIANCHI  
 JOB MANAGER L. FERNANDEZ  
 DESIGN SUPERVISOR B. SIVAKUMAR

FILE NAME = \$FILENAME\$  
 DATE/TIME = \$DATE\$  
 USER = \$USER\$

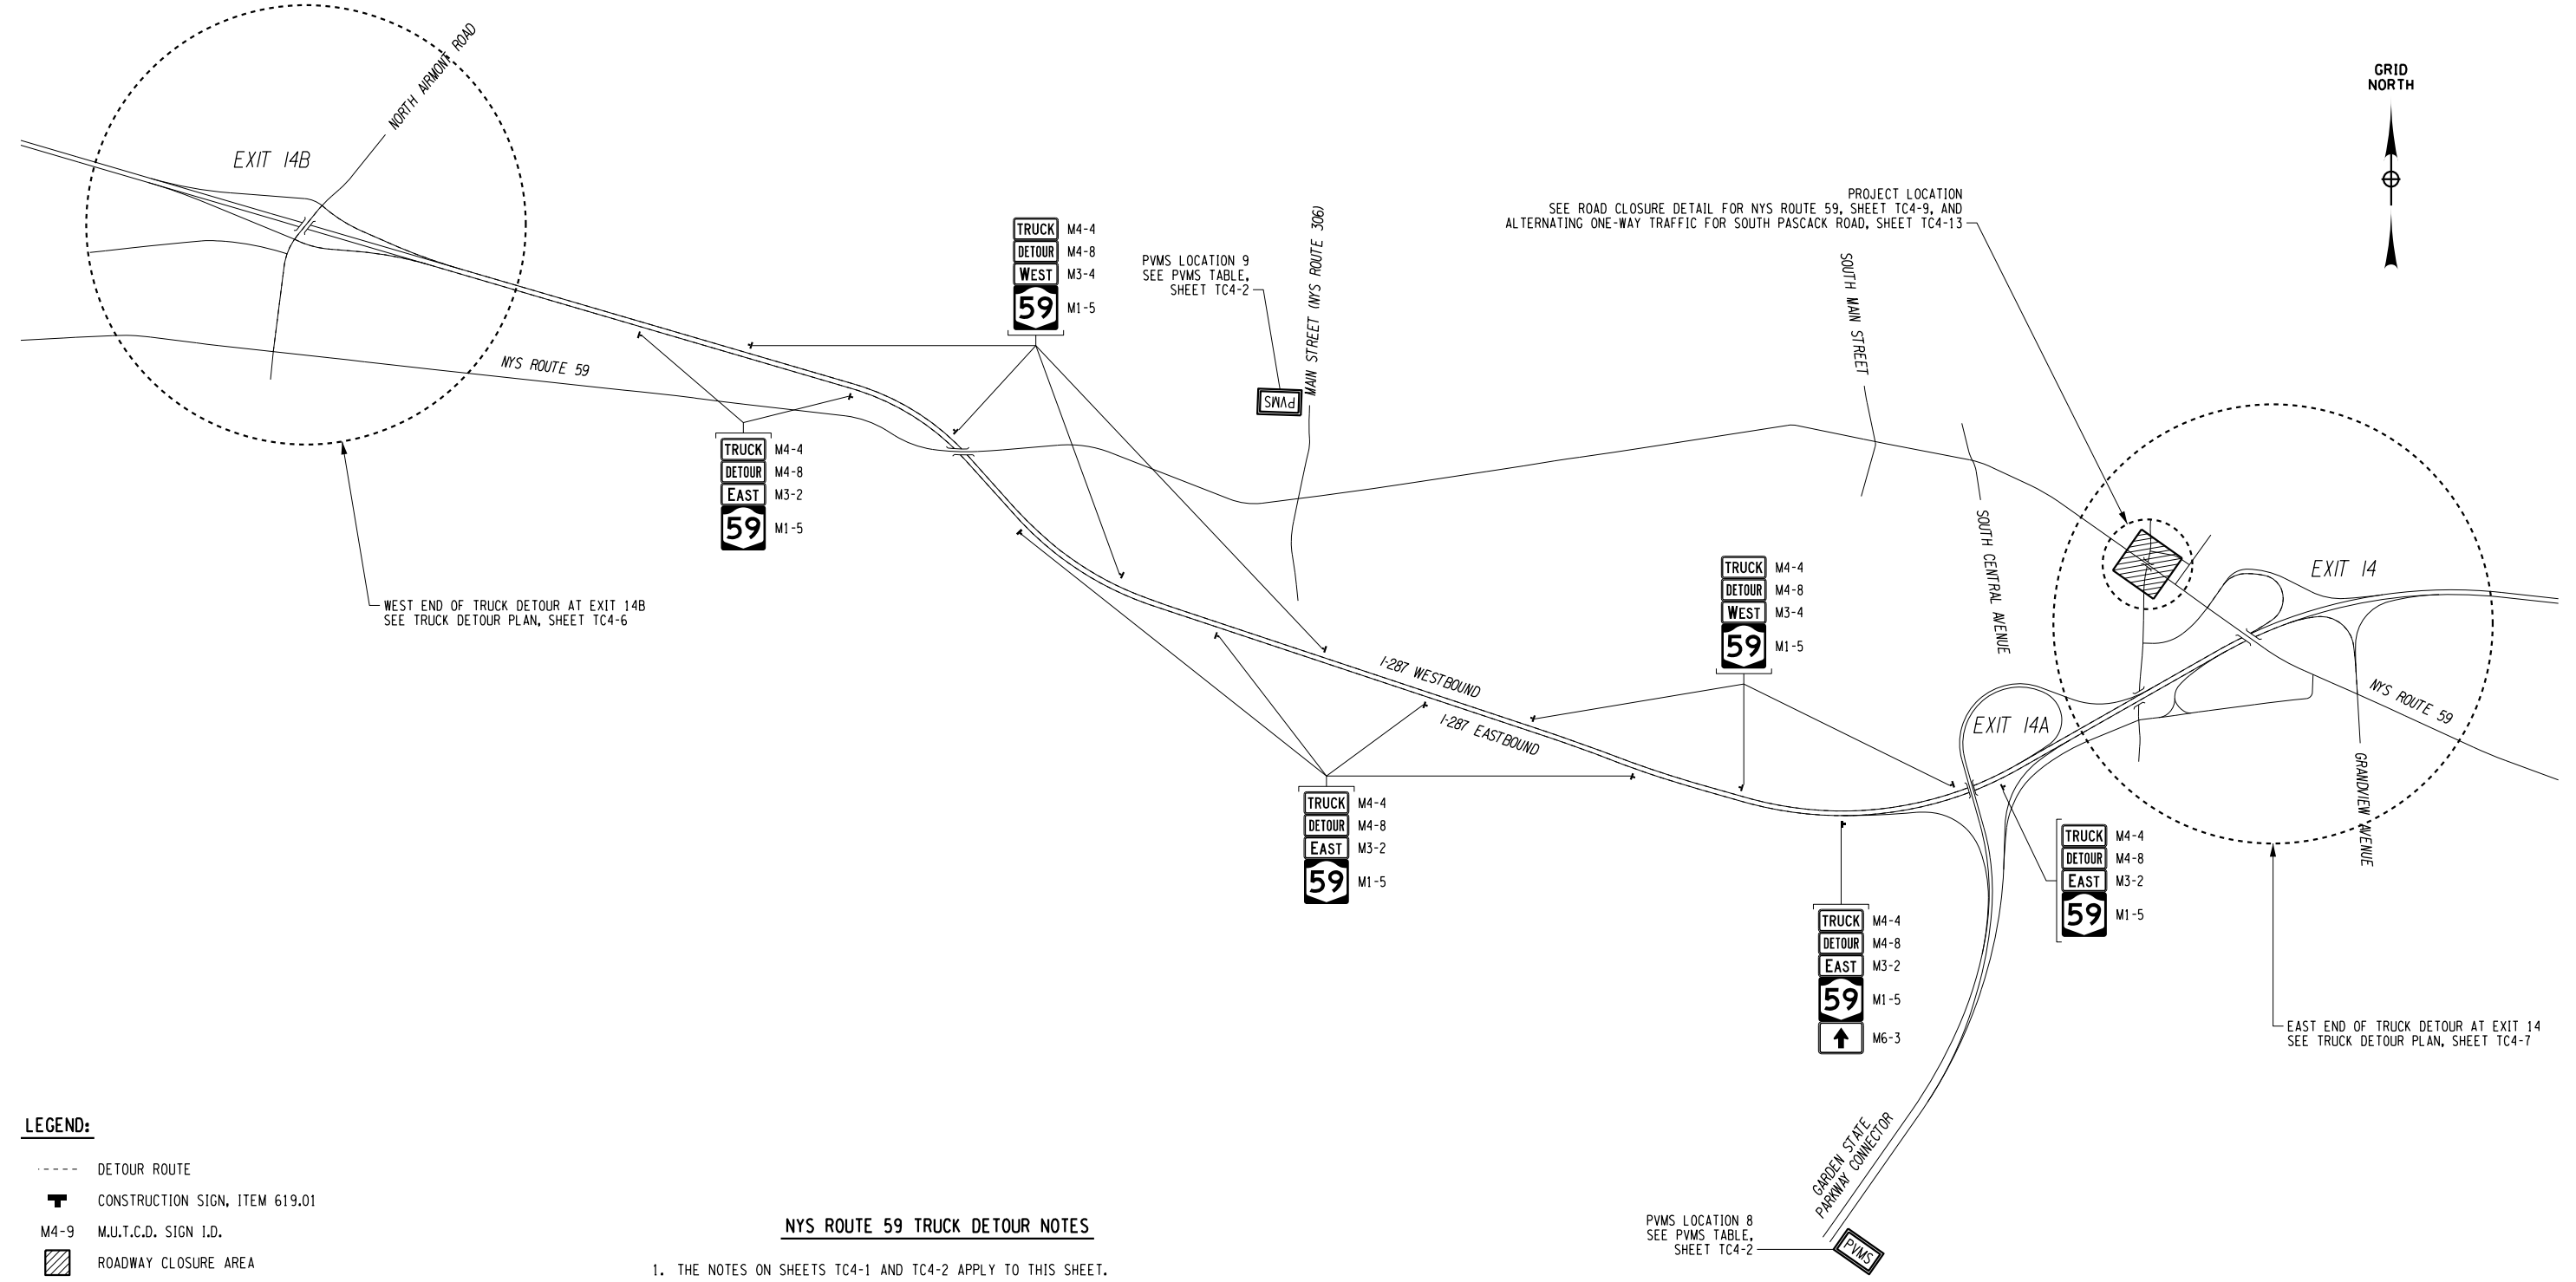

**LEGEND:**

- DETOUR ROUTE
- ▬ CONSTRUCTION SIGN, ITEM 619.01
- M4-9 M.U.T.C.D. SIGN I.D.
- ▨ ROADWAY CLOSURE AREA

**NYS ROUTE 59 TRUCK DETOUR NOTES**

1. THE NOTES ON SHEETS TC4-1 AND TC4-2 APPLY TO THIS SHEET.
2. THE NYS ROUTE 59 TRUCK DETOUR SHALL RUN CONCURRENT TO BOTH THE NYS ROUTE 59 AND SOUTH PASCACK ROAD DETOURS. THE CONTRACTOR SHALL COORDINATE ALL OVERLAPPING SIGNING BETWEEN THE VARIOUS DETOURS IN A MANNER AS APPROVED BY THE ENGINEER.
3. FOR CLARITY, ONLY SELECTED ROADWAYS ARE SHOWN ON THIS SHEET.
4. ALL SIGNS SHOWN ON THIS SHEET SHALL BE SPACED AT INTERVALS NO GREATER THAN 1/2 MILE.

AFFIX SEAL:  
ON:

ALTERED BY:  
ON:



AS-BUILT REVISIONS DESCRIPTION OF ALTERATIONS:	NYS DOT SUPERSTRUCTURE REPLACEMENT, ASSIGNMENT 6	PIN 8813.69	BRIDGES 1027670	CULVERTS	ALL DIMENSIONS IN ft UNLESS OTHERWISE NOTED	CONTRACT NUMBER D265445
	RT-59 OVER S. PASCACK ROAD					DETOUR PLAN (SHEET 3 OF 5) (RT-59 OVER S. PASCACK ROAD)
	VILLAGE OF SPRING VALLEY AND TOWN OF CLARKSTOWN					
	COUNTY: ROCKLAND	REGION: 8				


IT IS A VIOLATION OF LAW FOR ANY PERSON, UNLESS THEY ARE ACTING UNDER THE DIRECTION OF A LICENSED PROFESSIONAL ENGINEER, ARCHITECT, LANDSCAPE ARCHITECT, OR LAND SURVEYOR, TO ALTER AN ITEM IN ANY WAY. IF AN ITEM BEARING THE STAMP OF A LICENSED PROFESSIONAL IS ALTERED, THE ALTERING ENGINEER, ARCHITECT, LANDSCAPE ARCHITECT, OR LAND SURVEYOR SHALL STAMP THE DOCUMENT AND INCLUDE THE NOTATION "ALTERED BY" FOLLOWED BY THEIR SIGNATURE, THE DATE OF SUCH ALTERATION, AND A SPECIFIC DESCRIPTION OF THE ALTERATION.

FIELD REVISION SHEET

THIS SHEET DOES NOT SUPERSEDE ANY SHEET

NEW SHEET NUMBER: 86A3	DESCRIPTION: ADDED TRUCK DETOUR	DATE: MAY 14, 2026
------------------------	---------------------------------	--------------------

PROJECT MANAGER L. FERNANDEZ  
 CHECK C. BIANCHI  
 DRAFTING C. SARGEANT  
 CHECK C. SARGEANT  
 DESIGN C. BIANCHI  
 JOB MANAGER L. FERNANDEZ  
 DESIGN SUPERVISOR B. SIVAKUMAR

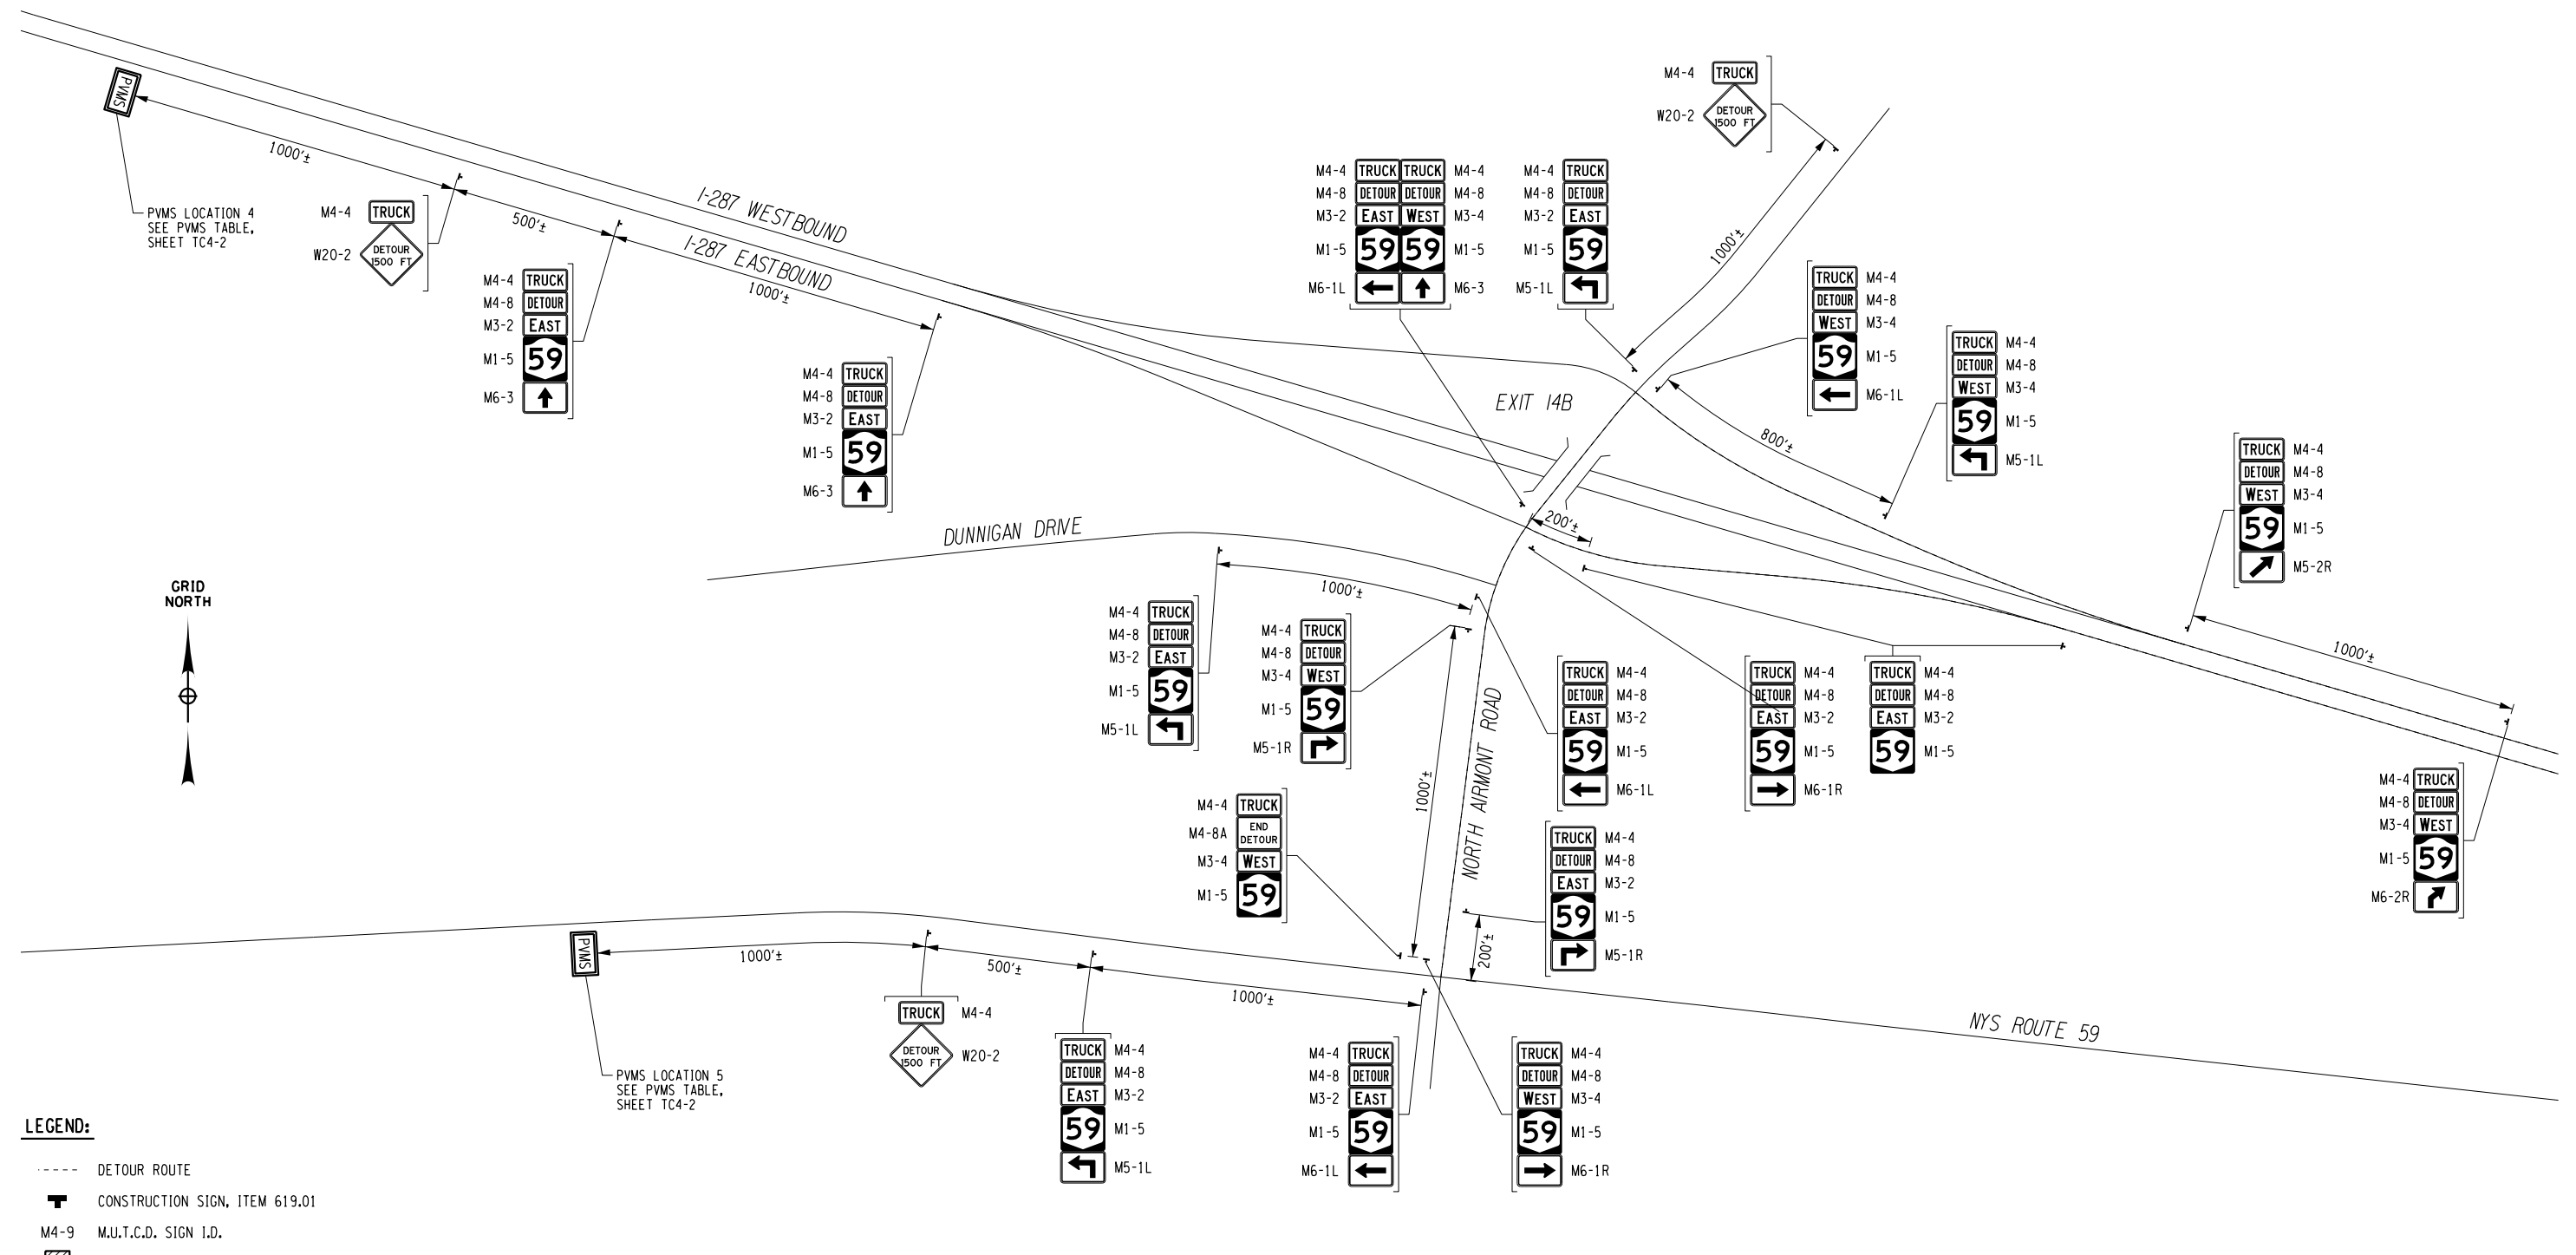

- LEGEND:**
- DETOUR ROUTE
  - CONSTRUCTION SIGN, ITEM 619.01
  - M4-9 M.U.T.C.D. SIGN I.D.
  - ▨ ROADWAY CLOSURE AREA

**NYS ROUTE 59 TRUCK DETOUR NOTES**

1. THE NOTES ON SHEETS TC4-1 AND TC4-2 APPLY TO THIS SHEET.
2. THE NYS ROUTE 59 TRUCK DETOUR SHALL RUN CONCURRENT TO BOTH THE NYS ROUTE 59 AND SOUTH PASCACK ROAD DETOURS. THE CONTRACTOR SHALL COORDINATE ALL OVERLAPPING SIGNING BETWEEN THE VARIOUS DETOURS IN A MANNER AS APPROVED BY THE ENGINEER.
3. FOR CLARITY, ONLY SELECTED ROADWAYS ARE SHOWN ON THIS SHEET.

AFFIX SEAL:  
ON:

ALTERED BY:  
ON:

AS-BUILT REVISIONS DESCRIPTION OF ALTERATIONS:	NYS DOT SUPERSTRUCTURE REPLACEMENT, ASSIGNMENT 6 RT-59 OVER S. PASCACK ROAD	PIN 8813.69	BRIDGES 1027670	CULVERTS	ALL DIMENSIONS IN FT UNLESS OTHERWISE NOTED	CONTRACT NUMBER D265445
	VILLAGE OF SPRING VALLEY AND TOWN OF CLARKSTOWN				DETOUR PLAN (SHEET 4 OF 5) (RT-59 OVER S. PASCACK ROAD)	DRAWING NO. TC4-6 SHEET NO. 86A4
	COUNTY: ROCKLAND REGION: 8					

IT IS A VIOLATION OF LAW FOR ANY PERSON, UNLESS THEY ARE ACTING UNDER THE DIRECTION OF A LICENSED PROFESSIONAL ENGINEER, ARCHITECT, LANDSCAPE ARCHITECT, OR LAND SURVEYOR, TO ALTER AN ITEM IN ANY WAY. IF AN ITEM BEARING THE STAMP OF A LICENSED PROFESSIONAL IS ALTERED, THE ALTERING ENGINEER, ARCHITECT, LANDSCAPE ARCHITECT, OR LAND SURVEYOR SHALL STAMP THE DOCUMENT AND INCLUDE THE NOTATION "ALTERED BY" FOLLOWED BY THEIR SIGNATURE, THE DATE OF SUCH ALTERATION, AND A SPECIFIC DESCRIPTION OF THE ALTERATION.

FIELD REVISION SHEET

THIS SHEET DOES NOT SUPERSEDE ANY SHEET

NEW SHEET NUMBER: 86A4	DESCRIPTION: ADDED TRUCK DETOUR	DATE: MAY 14, 2026
------------------------	---------------------------------	--------------------



FILE NAME = \$FILENAME\$  
 DATE/TIME = \$DATE\$  
 USER = \$USERNAME\$


PROJECT MANAGER L. FERNANDEZ  
 CHECK C. BIANCHI  
 DRAFTING C. SARGEANT  
 CHECK C. SARGEANT  
 DESIGN C. BIANCHI  
 JOB MANAGER L. FERNANDEZ  
 DESIGN SUPERVISOR B. SIVAKUMAR

**LEGEND:**

- DETOUR ROUTE
- ▬ CONSTRUCTION SIGN, ITEM 619.01
- M4-9 M.U.T.C.D. SIGN I.D.
- ▨ ROADWAY CLOSURE AREA



PROJECT LOCATION  
 SEE ROAD CLOSURE DETAIL FOR  
 NYS ROUTE 59, SHEET TC4-9, AND  
 ALTERNATING ONE-WAY TRAFFIC FOR  
 SOUTH PASCACK ROAD, SHEET TC4-13

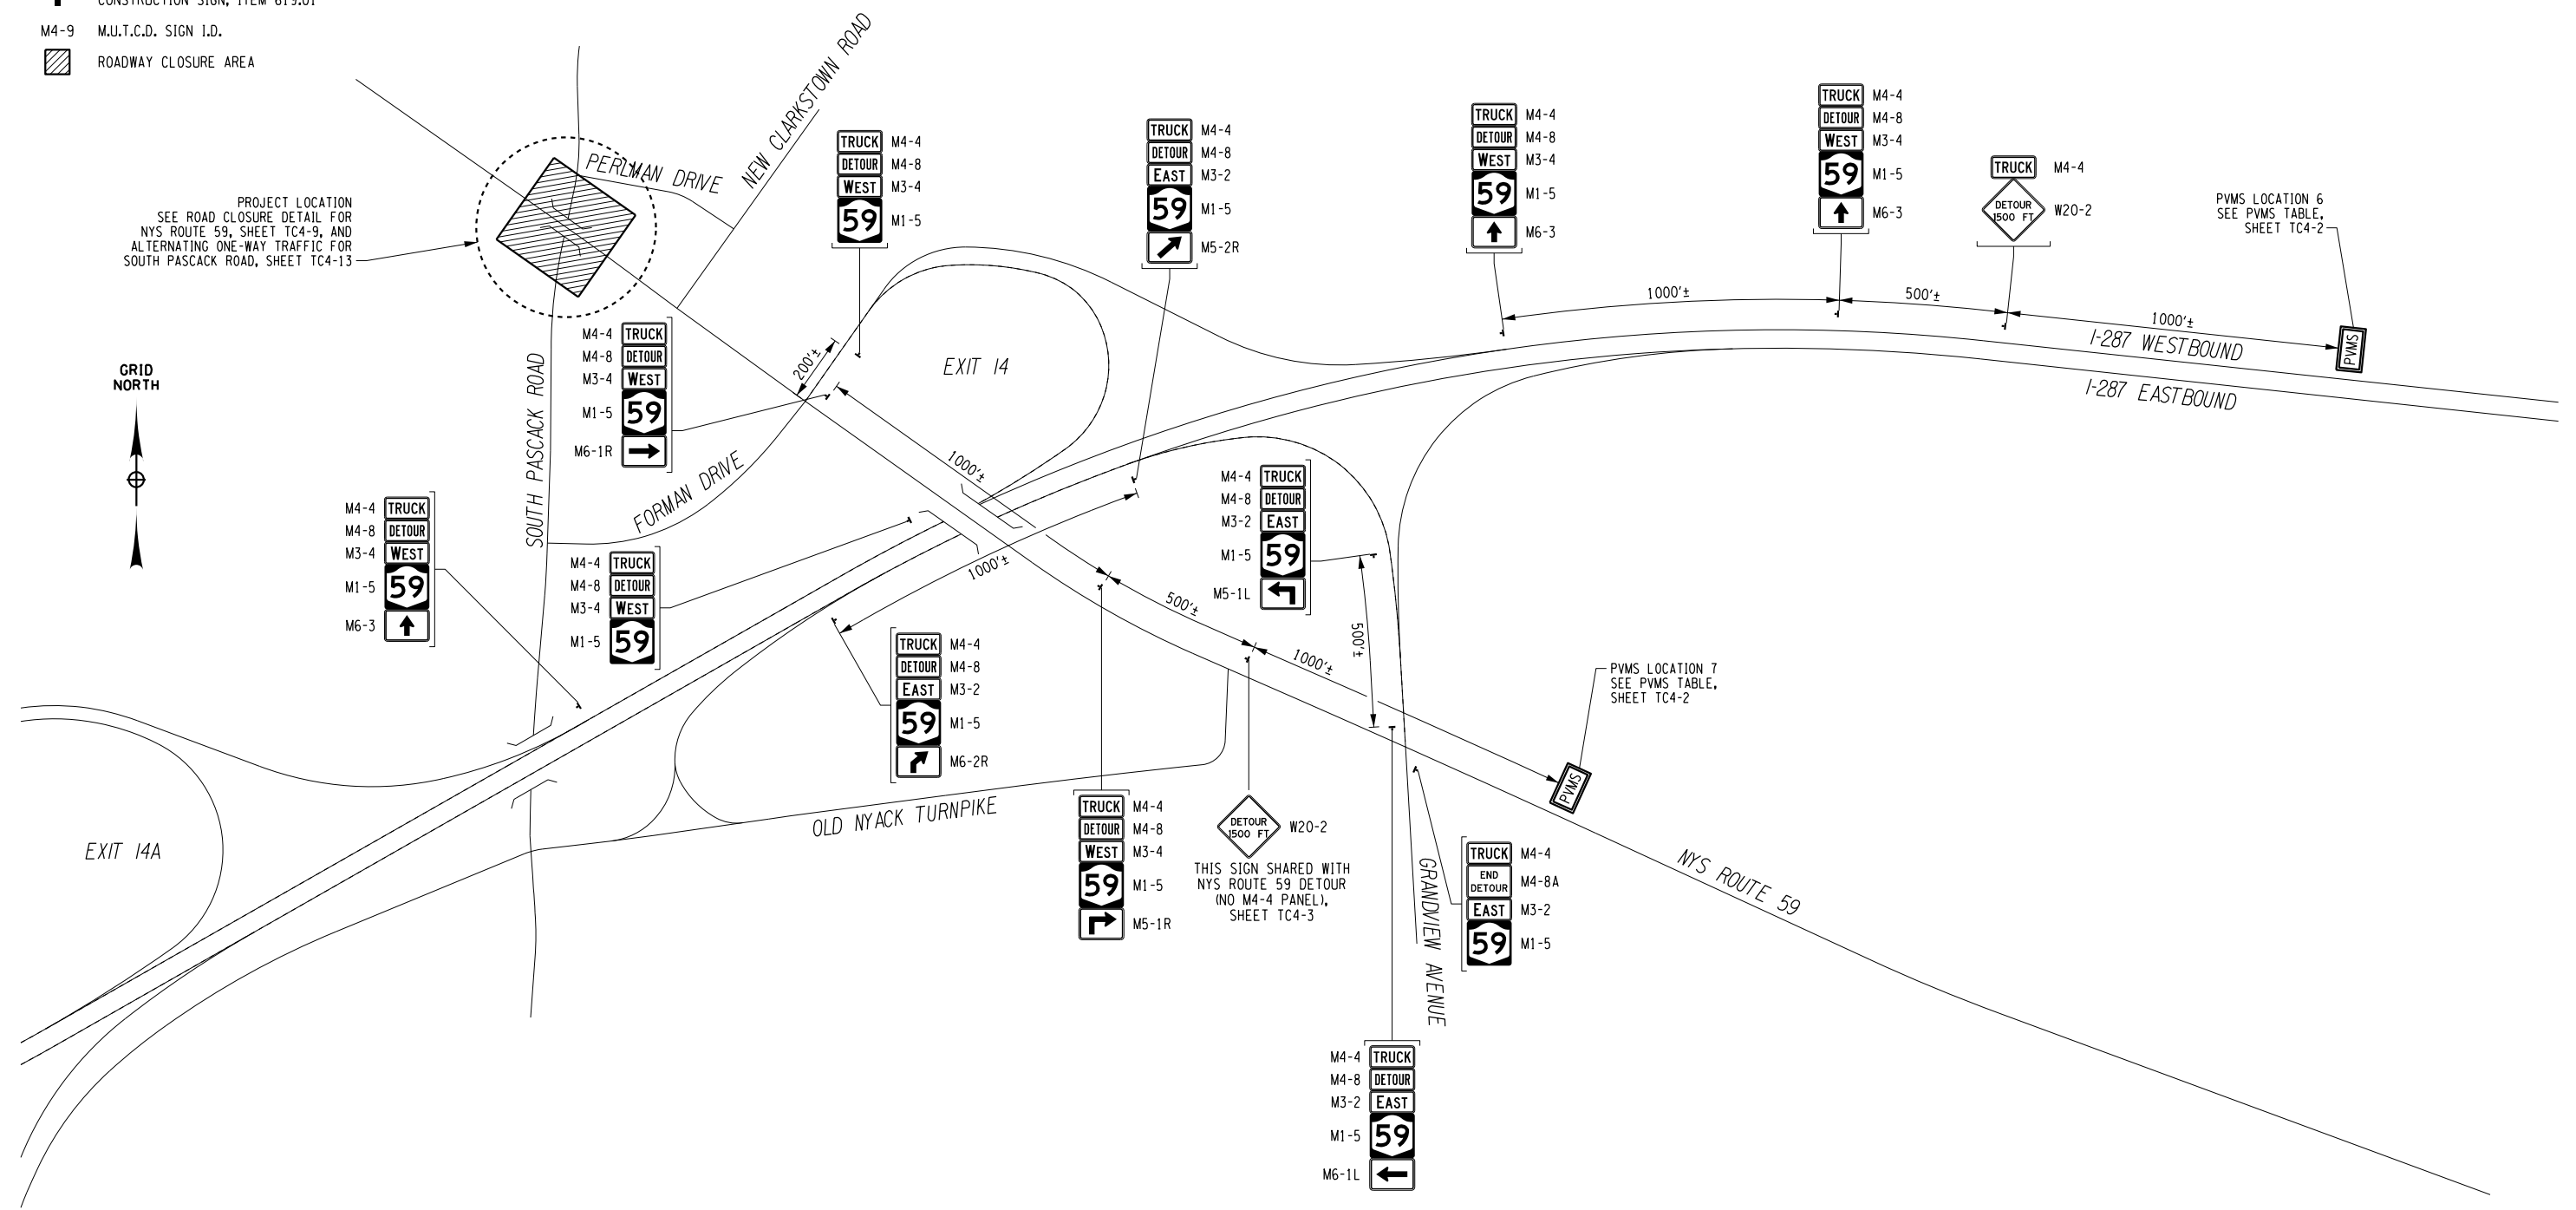

**NYS ROUTE 59 TRUCK DETOUR NOTES**

1. THE NOTES ON SHEETS TC4-1 AND TC4-2 APPLY TO THIS SHEET.
2. THE NYS ROUTE 59 TRUCK DETOUR SHALL RUN CONCURRENT TO BOTH THE NYS ROUTE 59 AND SOUTH PASCACK ROAD DETOURS. THE CONTRACTOR SHALL COORDINATE ALL OVERLAPPING SIGNING BETWEEN THE VARIOUS DETOURS IN A MANNER AS APPROVED BY THE ENGINEER.
3. FOR CLARITY, ONLY SELECTED ROADWAYS ARE SHOWN ON THIS SHEET.

AFFIX SEAL:  
ON:

ALTERED BY:  
ON:

AS-BUILT REVISIONS DESCRIPTION OF ALTERATIONS:	NYSOT SUPERSTRUCTURE REPLACEMENT, ASSIGNMENT 6 RT-59 OVER S. PASCACK ROAD	PIN 8813.69	BRIDGES 102760	CULVERTS	ALL DIMENSIONS IN FT UNLESS OTHERWISE NOTED	CONTRACT NUMBER D265445
	VILLAGE OF SPRING VALLEY AND TOWN OF CLARKSTOWN				DETOUR PLAN (SHEET 5 OF 5) (RT-59 OVER S. PASCACK ROAD)	DRAWING NO. TC4-7 SHEET NO. 86A5
	COUNTY: ROCKLAND REGION: 8					
IT IS A VIOLATION OF LAW FOR ANY PERSON, UNLESS THEY ARE ACTING UNDER THE DIRECTION OF A LICENSED PROFESSIONAL ENGINEER, ARCHITECT, LANDSCAPE ARCHITECT, OR LAND SURVEYOR, TO ALTER AN ITEM IN ANY WAY. IF AN ITEM BEARING THE STAMP OF A LICENSED PROFESSIONAL IS ALTERED, THE ALTERING ENGINEER, ARCHITECT, LANDSCAPE ARCHITECT, OR LAND SURVEYOR SHALL STAMP THE DOCUMENT AND INCLUDE THE NOTATION "ALTERED BY" FOLLOWED BY THEIR SIGNATURE, THE DATE OF SUCH ALTERATION, AND A SPECIFIC DESCRIPTION OF THE ALTERATION.						

FIELD REVISION SHEET

THIS SHEET DOES NOT SUPERSEDE ANY SHEET




NEW SHEET NUMBER: 86A5	DESCRIPTION: ADDED TRUCK DETOUR	DATE: MAY 14, 2026
------------------------	---------------------------------	--------------------




FILE NAME = \$FILENAME\$  
 DATE/TIME = \$DATE\$  
 USER = \$USERNAME\$

PROJECT MANAGER L. FERNANDEZ  
 CHECK C. BIANCHI  
 DRAFTING C. SARGEANT  
 CHECK C. SARGEANT  
 DESIGN C. BIANCHI  
 JOB MANAGER L. FERNANDEZ  
 DESIGN SUPERVISOR B. SIVAKUMAR


**LEGEND:**

-  TYPE 3 BARRICADE, ITEM 619.04
-  CONSTRUCTION SIGN, ITEM 619.01
- M4-9 M.U.T.C.D. SIGN I.D.
-  CHANNELIZING DEVICE, ITEM 619.01

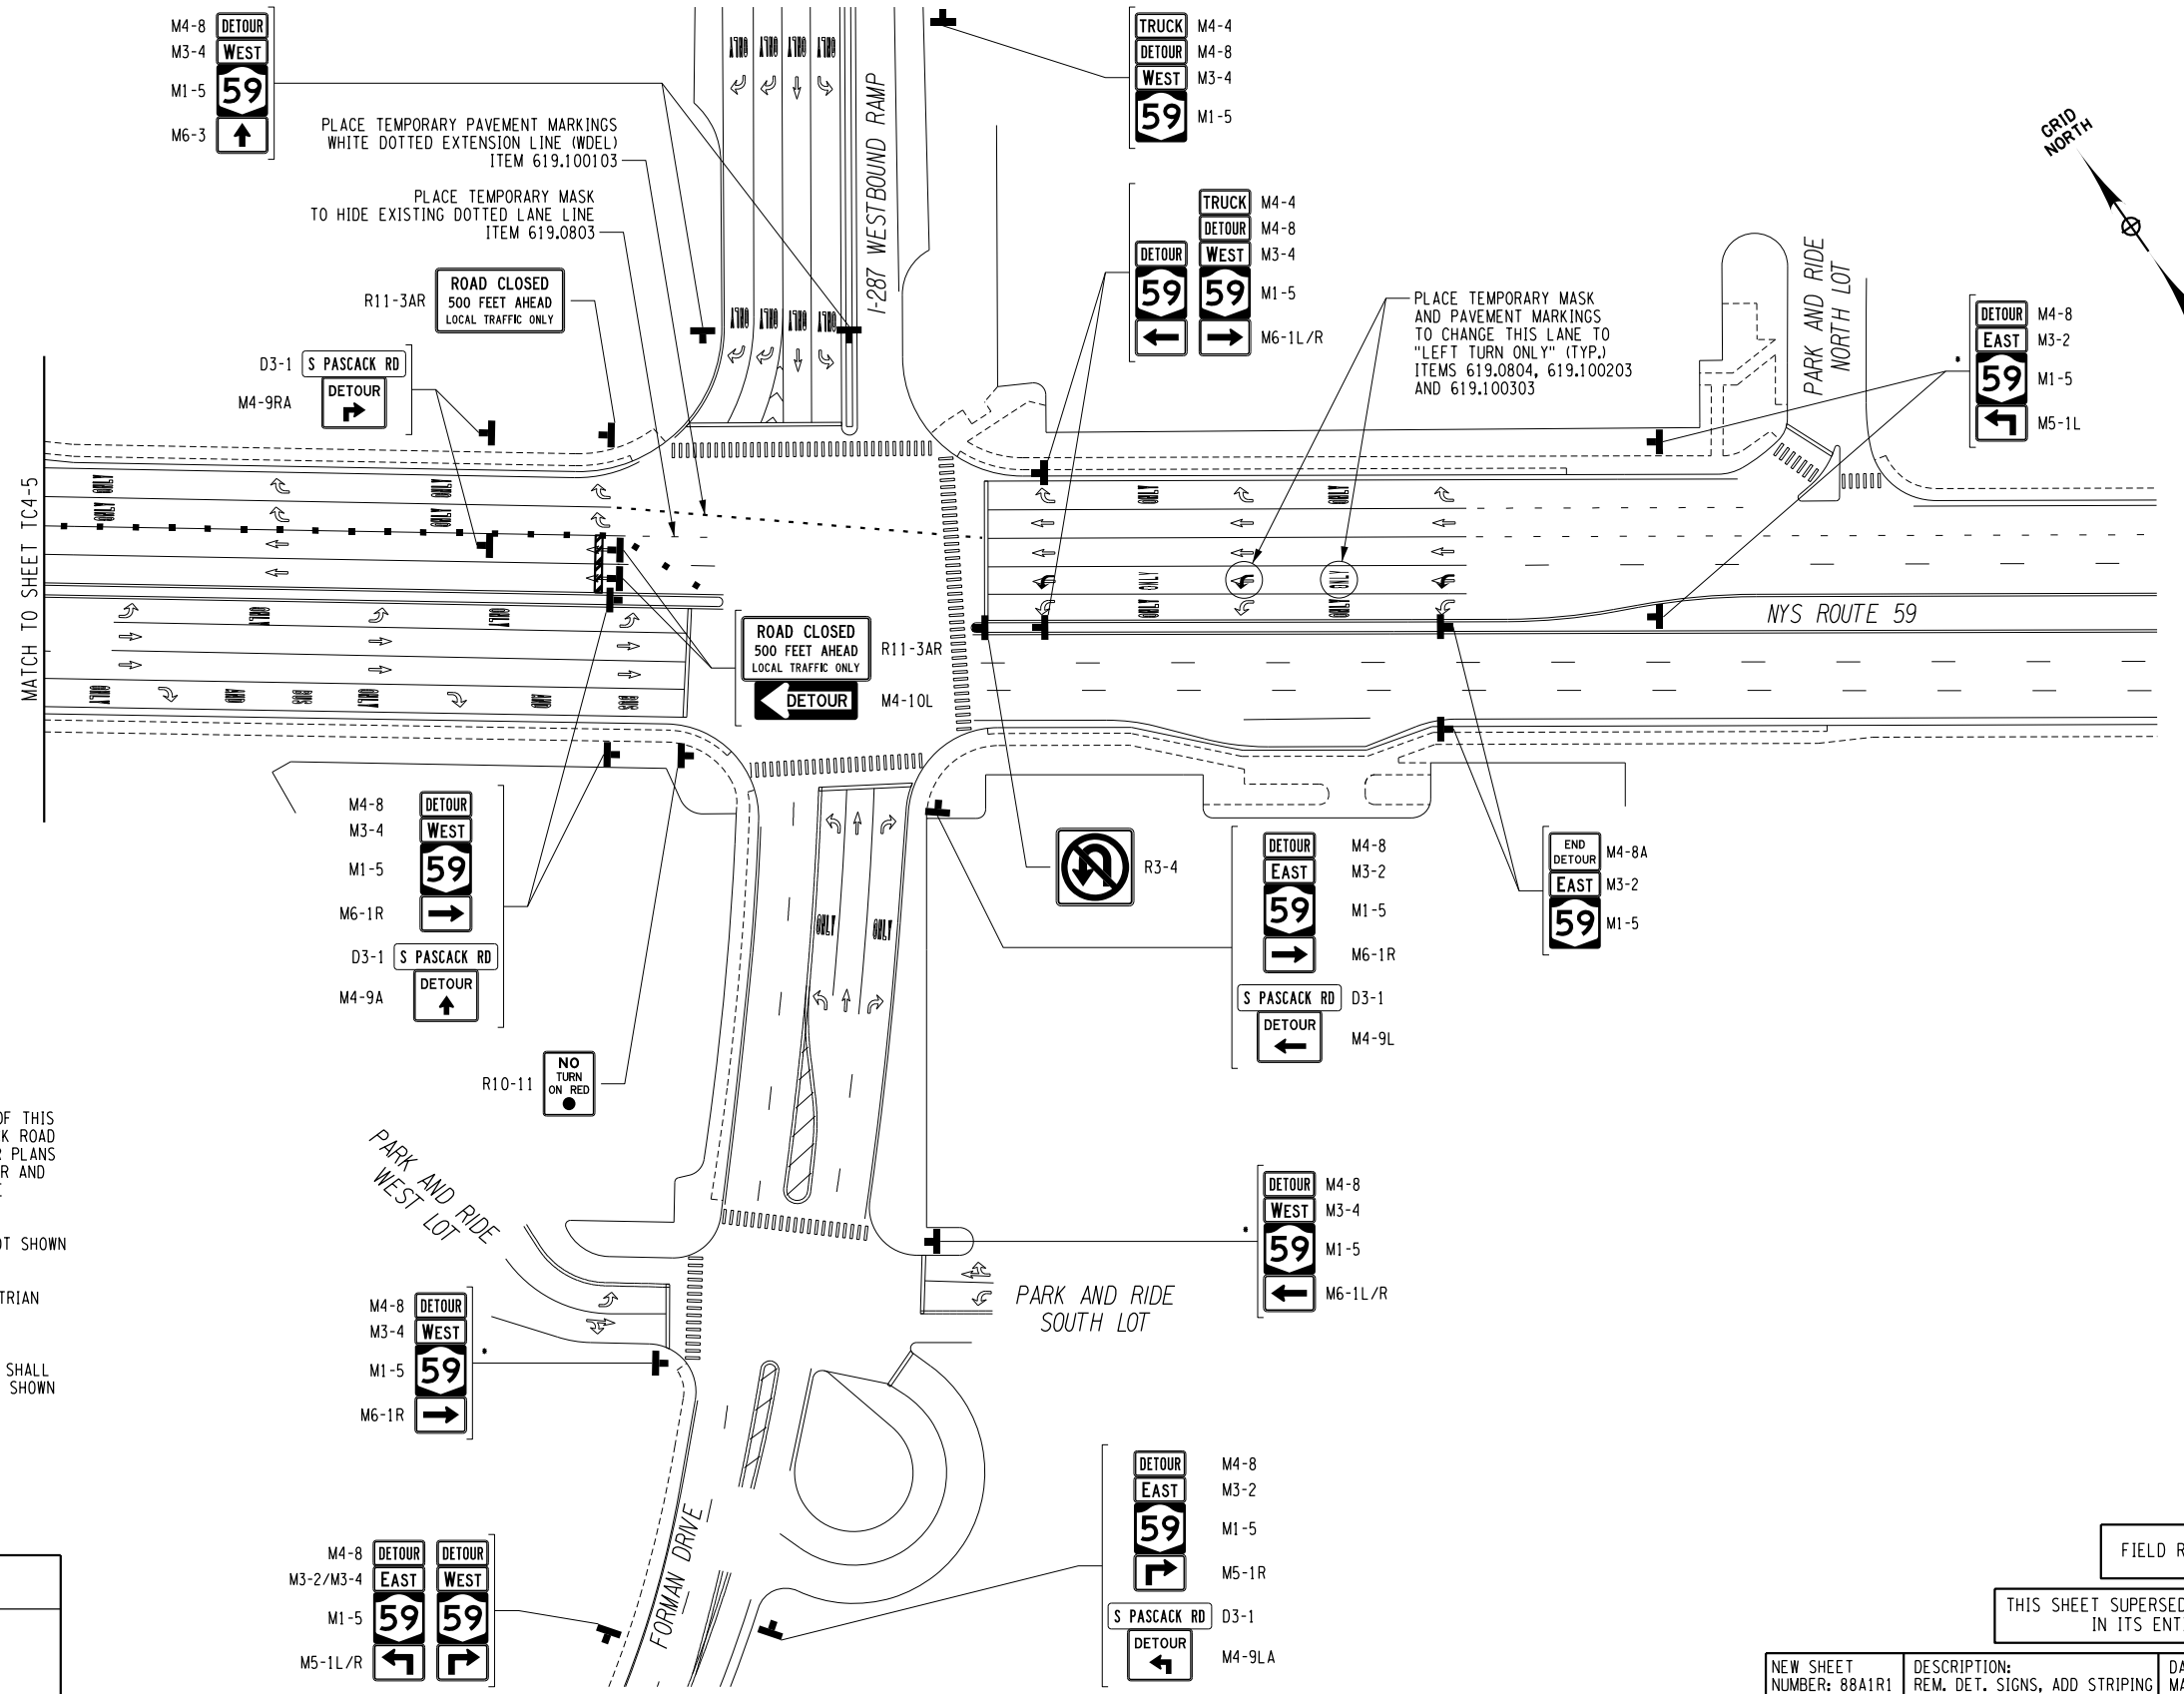


**WORK ZONE TRAFFIC CONTROL PLAN NOTES**

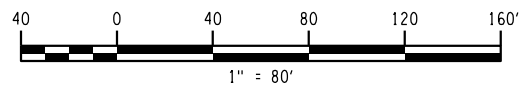

1. ONLY DETOUR WAYFINDING SIGN LOCATIONS THAT FALL WITHIN THE RANGE OF THIS SHEET ARE SHOWN. SEE THE NYS ROUTE 59 (SHEET TC4-3), SOUTH PASCACK ROAD (TC4-4), AND NYS ROUTE 59 TRUCK (SHEETS TC4-5 THROUGH TC4-7) DETOUR PLANS FOR ADDITIONAL SIGNING. THE CONTRACTOR SHALL COORDINATE ALL DETOUR AND WORK ZONE SIGNS WITH EXISTING SIGNS IN A MANNER AS APPROVED BY THE ENGINEER.
2. DETOUR WAYFINDING SIGN LOCATIONS MARKED WITH AN ASTERISK (\*) ARE NOT SHOWN ON THE DETOUR SHEETS REFERENCED IN NOTE 1.
3. SIGNS IN OR ADJACENT TO SIDEWALKS SHALL NOT INFRINGE ON THE PEDESTRIAN ACCESS ROUTE AND SHALL BE POSITIONED SUCH AS TO NOT CREATE AN OBSTRUCTION OR HAZARD TO PEDESTRIANS.
4. THE EXACT LAYOUT OF SIGN LOCATIONS SHOWING MULTIPLE SIGN PACKAGES SHALL BE DETERMINED IN THE FIELD AND NEED NOT BE ARRANGED VERTICALLY AS SHOWN ON THIS SHEET.



AFFIX SEAL:  
ON:

ALTERED BY:  
ON:



AS-BUILT REVISIONS DESCRIPTION OF ALTERATIONS:	NYS DOT SUPERSTRUCTURE REPLACEMENT, ASSIGNMENT 6	PIN 8813.69	BRIDGES 102760	CULVERTS	ALL DIMENSIONS IN FT UNLESS OTHERWISE NOTED	CONTRACT NUMBER D265445
	RT-59 OVER S. PASCACK ROAD					WORK ZONE TRAFFIC CONTROL PLAN (SHEET 1 OF 6) (RT-59 OVER S. PASCACK ROAD)
	VILLAGE OF SPRING VALLEY AND TOWN OF CLARKSTOWN					
	COUNTY: ROCKLAND REGION: 8					
IT IS A VIOLATION OF LAW FOR ANY PERSON, UNLESS THEY ARE ACTING UNDER THE DIRECTION OF A LICENSED PROFESSIONAL ENGINEER, ARCHITECT, LANDSCAPE ARCHITECT, OR LAND SURVEYOR, TO ALTER AN ITEM IN ANY WAY. IF AN ITEM BEARING THE STAMP OF A LICENSED PROFESSIONAL IS ALTERED, THE ALTERING ENGINEER, ARCHITECT, LANDSCAPE ARCHITECT, OR LAND SURVEYOR SHALL STAMP THE DOCUMENT AND INCLUDE THE NOTATION "ALTERED BY" FOLLOWED BY THEIR SIGNATURE, THE DATE OF SUCH ALTERATION, AND A SPECIFIC DESCRIPTION OF THE ALTERATION.						 

FIELD REVISION SHEET




THIS SHEET SUPERSEDES SHEET 88A1 IN ITS ENTIRETY

NEW SHEET NUMBER: 88A1R1	DESCRIPTION: REM. DET. SIGNS, ADD STRIPING	DATE: MAY 14, 2026
--------------------------	--	--------------------

FILE NAME = \$FILENAME\$  
 DATE/TIME = \$DATE\$  
 USER = \$USERNAME\$




PROJECT MANAGER L. FERNANDEZ  
 CHECK C. BIANCHI  
 DRAFTING C. SARGEANT  
 DESIGN C. BIANCHI  
 JOB MANAGER L. FERNANDEZ  
 DESIGN SUPERVISOR B. SIVAKUMAR

**LEGEND:**

-  TYPE 3 BARRICADE, ITEM 619.04
-  CONSTRUCTION SIGN, ITEM 619.01
- M4-9 M.U.T.C.D. SIGN I.D.
-  CHANNELIZING DEVICE, ITEM 619.01

**WORK ZONE TRAFFIC CONTROL PLAN NOTES**


1. ONLY DETOUR WAYFINDING SIGN LOCATIONS THAT FALL WITHIN THE RANGE OF THIS SHEET ARE SHOWN. SEE THE NYS ROUTE 59 (SHEET TC4-3), SOUTH PASCACK ROAD (TC4-4), AND NYS ROUTE 59 TRUCK (SHEETS TC4-5 THROUGH TC4-7) DETOUR PLANS FOR ADDITIONAL SIGNING. THE CONTRACTOR SHALL COORDINATE ALL DETOUR AND WORK ZONE SIGNS WITH EXISTING SIGNS IN A MANNER AS APPROVED BY THE ENGINEER.
2. SIGNS IN OR ADJACENT TO SIDEWALKS SHALL NOT INFRINGE ON THE PEDESTRIAN ACCESS ROUTE AND SHALL BE POSITIONED SUCH AS TO NOT CREATE AN OBSTRUCTION OR HAZARD TO PEDESTRIANS.
3. THE EXACT LAYOUT OF SIGN LOCATIONS SHOWING MULTIPLE SIGN PACKAGES SHALL BE DETERMINED IN THE FIELD AND NEED NOT BE ARRANGED VERTICALLY AS SHOWN ON THIS SHEET.
4. SIGN SIZE, LEGEND, AND PLACEMENT SHALL BE AS APPROVED BY THE ENGINEER.

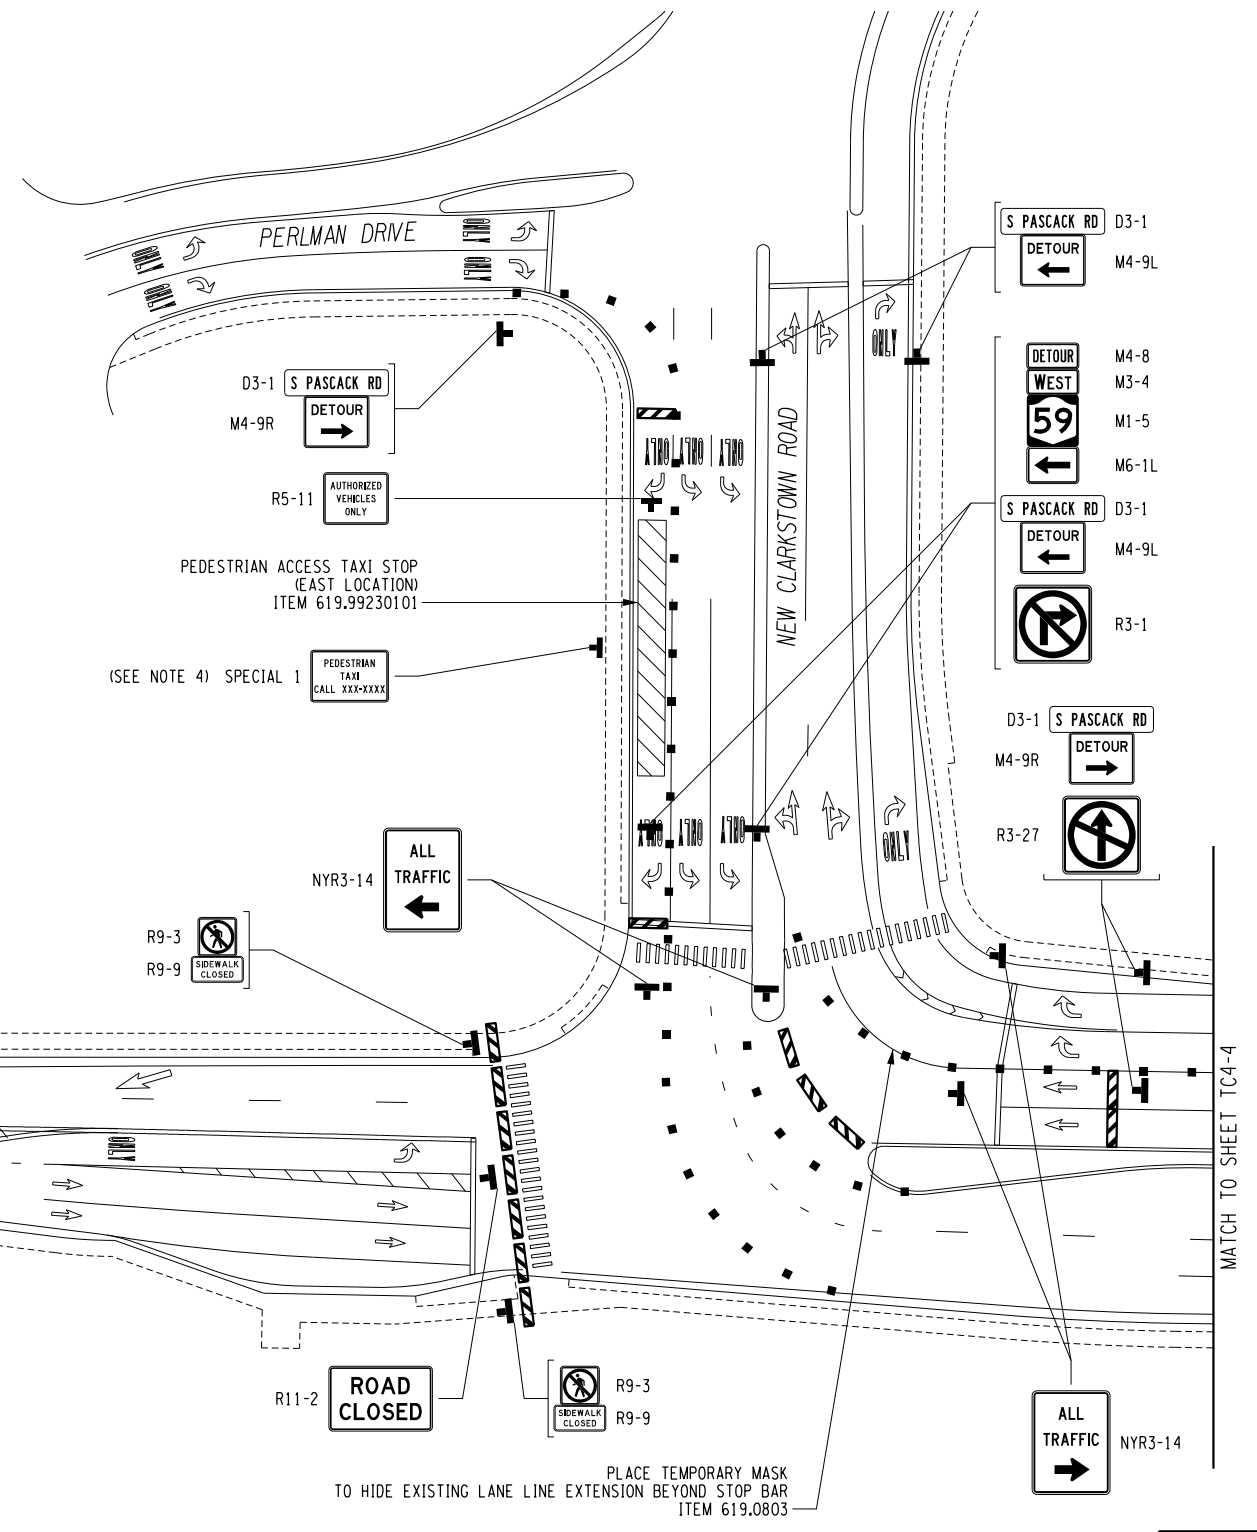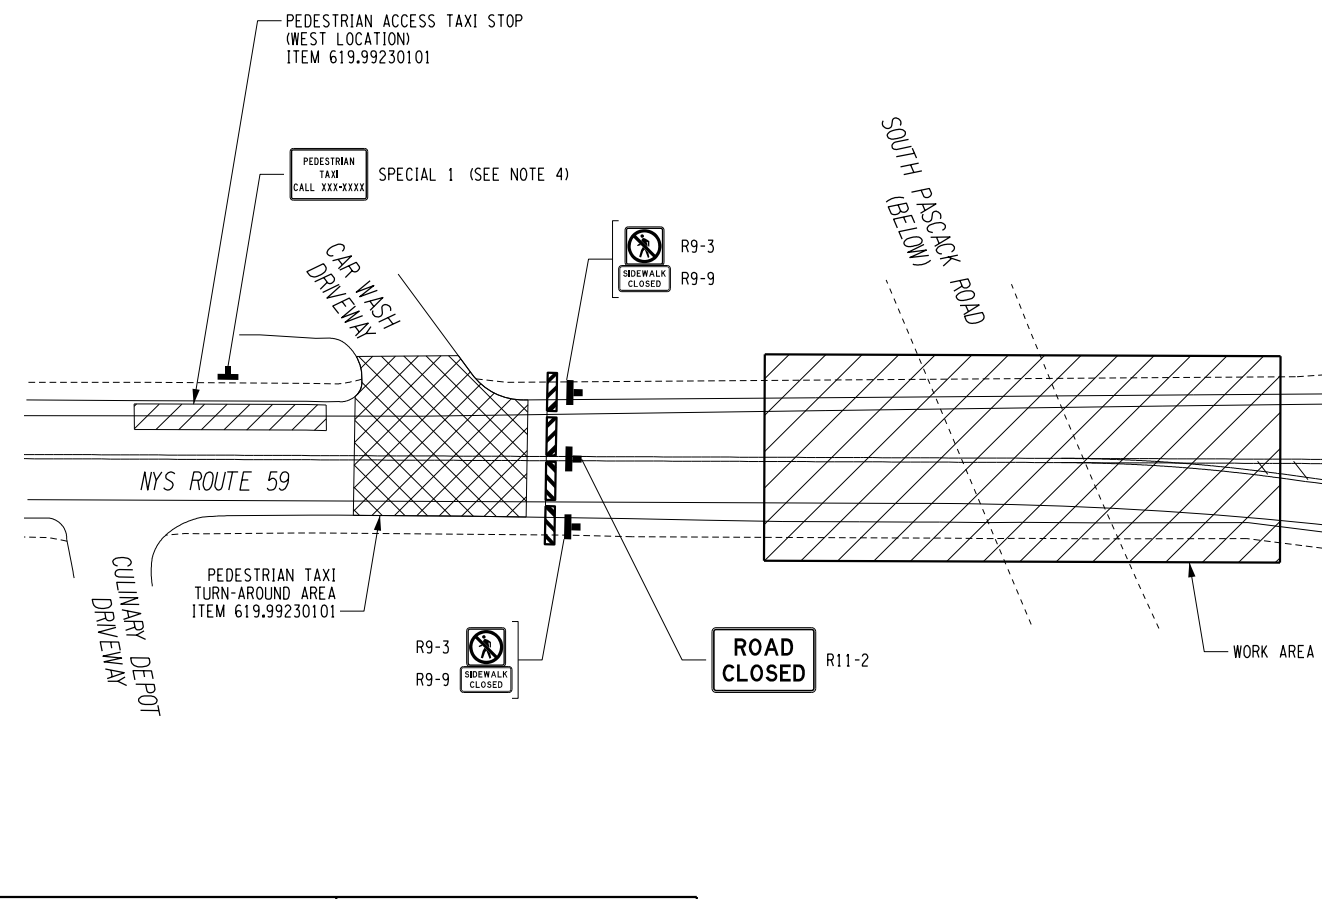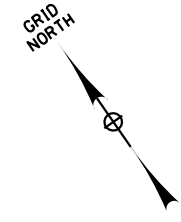

MATCH TO SHEET TC4-4

AFFIX SEAL: ON: \_\_\_\_\_

ALTERED BY: ON: \_\_\_\_\_

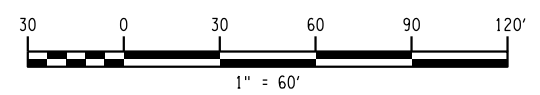AS-BUILT REVISIONS DESCRIPTION OF ALTERATIONS:	NYSOT SUPERSTRUCTURE REPLACEMENT, ASSIGNMENT 6 RT-59 OVER S. PASCACK ROAD	PIN 8813.69	BRIDGES 102760	CULVERTS	ALL DIMENSIONS IN FT UNLESS OTHERWISE NOTED	CONTRACT NUMBER D265445
	VILLAGE OF SPRING VALLEY AND TOWN OF CLARKSTOWN				WORK ZONE TRAFFIC CONTROL PLAN (SHEET 2 OF 6) (RT-59 OVER S. PASCACK ROAD)	DRAWING NO. TC4-9 SHEET NO. 89A1R1
	COUNTY: ROCKLAND REGION: 8					

IT IS A VIOLATION OF LAW FOR ANY PERSON, UNLESS THEY ARE ACTING UNDER THE DIRECTION OF A LICENSED PROFESSIONAL ENGINEER, ARCHITECT, LANDSCAPE ARCHITECT, OR LAND SURVEYOR, TO ALTER AN ITEM IN ANY WAY. IF AN ITEM BEARING THE STAMP OF A LICENSED PROFESSIONAL IS ALTERED, THE ALTERING ENGINEER, ARCHITECT, LANDSCAPE ARCHITECT, OR LAND SURVEYOR SHALL STAMP THE DOCUMENT AND INCLUDE THE NOTATION "ALTERED BY" FOLLOWED BY THEIR SIGNATURE, THE DATE OF SUCH ALTERATION, AND A SPECIFIC DESCRIPTION OF THE ALTERATION.




FIELD REVISION SHEET


THIS SHEET SUPERSEDES SHEET 89A1 IN ITS ENTIRETY

NEW SHEET NUMBER: 89A1R1	DESCRIPTION: ADDED SIGNS	DATE: MAY 14, 2026
--------------------------	--------------------------	--------------------

FILE NAME = \$FILENAME\$  
 DATE/TIME = \$DATE\$  
 USER = \$USERNAME\$


PROJECT MANAGER L. FERNANDEZ  
 CHECK C. BIANCHI  
 DRAFTING C. SARGEANT  
 CHECK C. SARGEANT  
 DESIGN C. BIANCHI  
 JOB MANAGER L. FERNANDEZ  
 DESIGN SUPERVISOR B. SIVAKUMAR

- LEGEND:**
-  TYPE 3 BARRICADE, ITEM 619.04
  -  CONSTRUCTION SIGN, ITEM 619.01
  - M4-9 M.U.T.C.D. SIGN I.D.
  -  CHANNELIZING DEVICE, ITEM 619.01

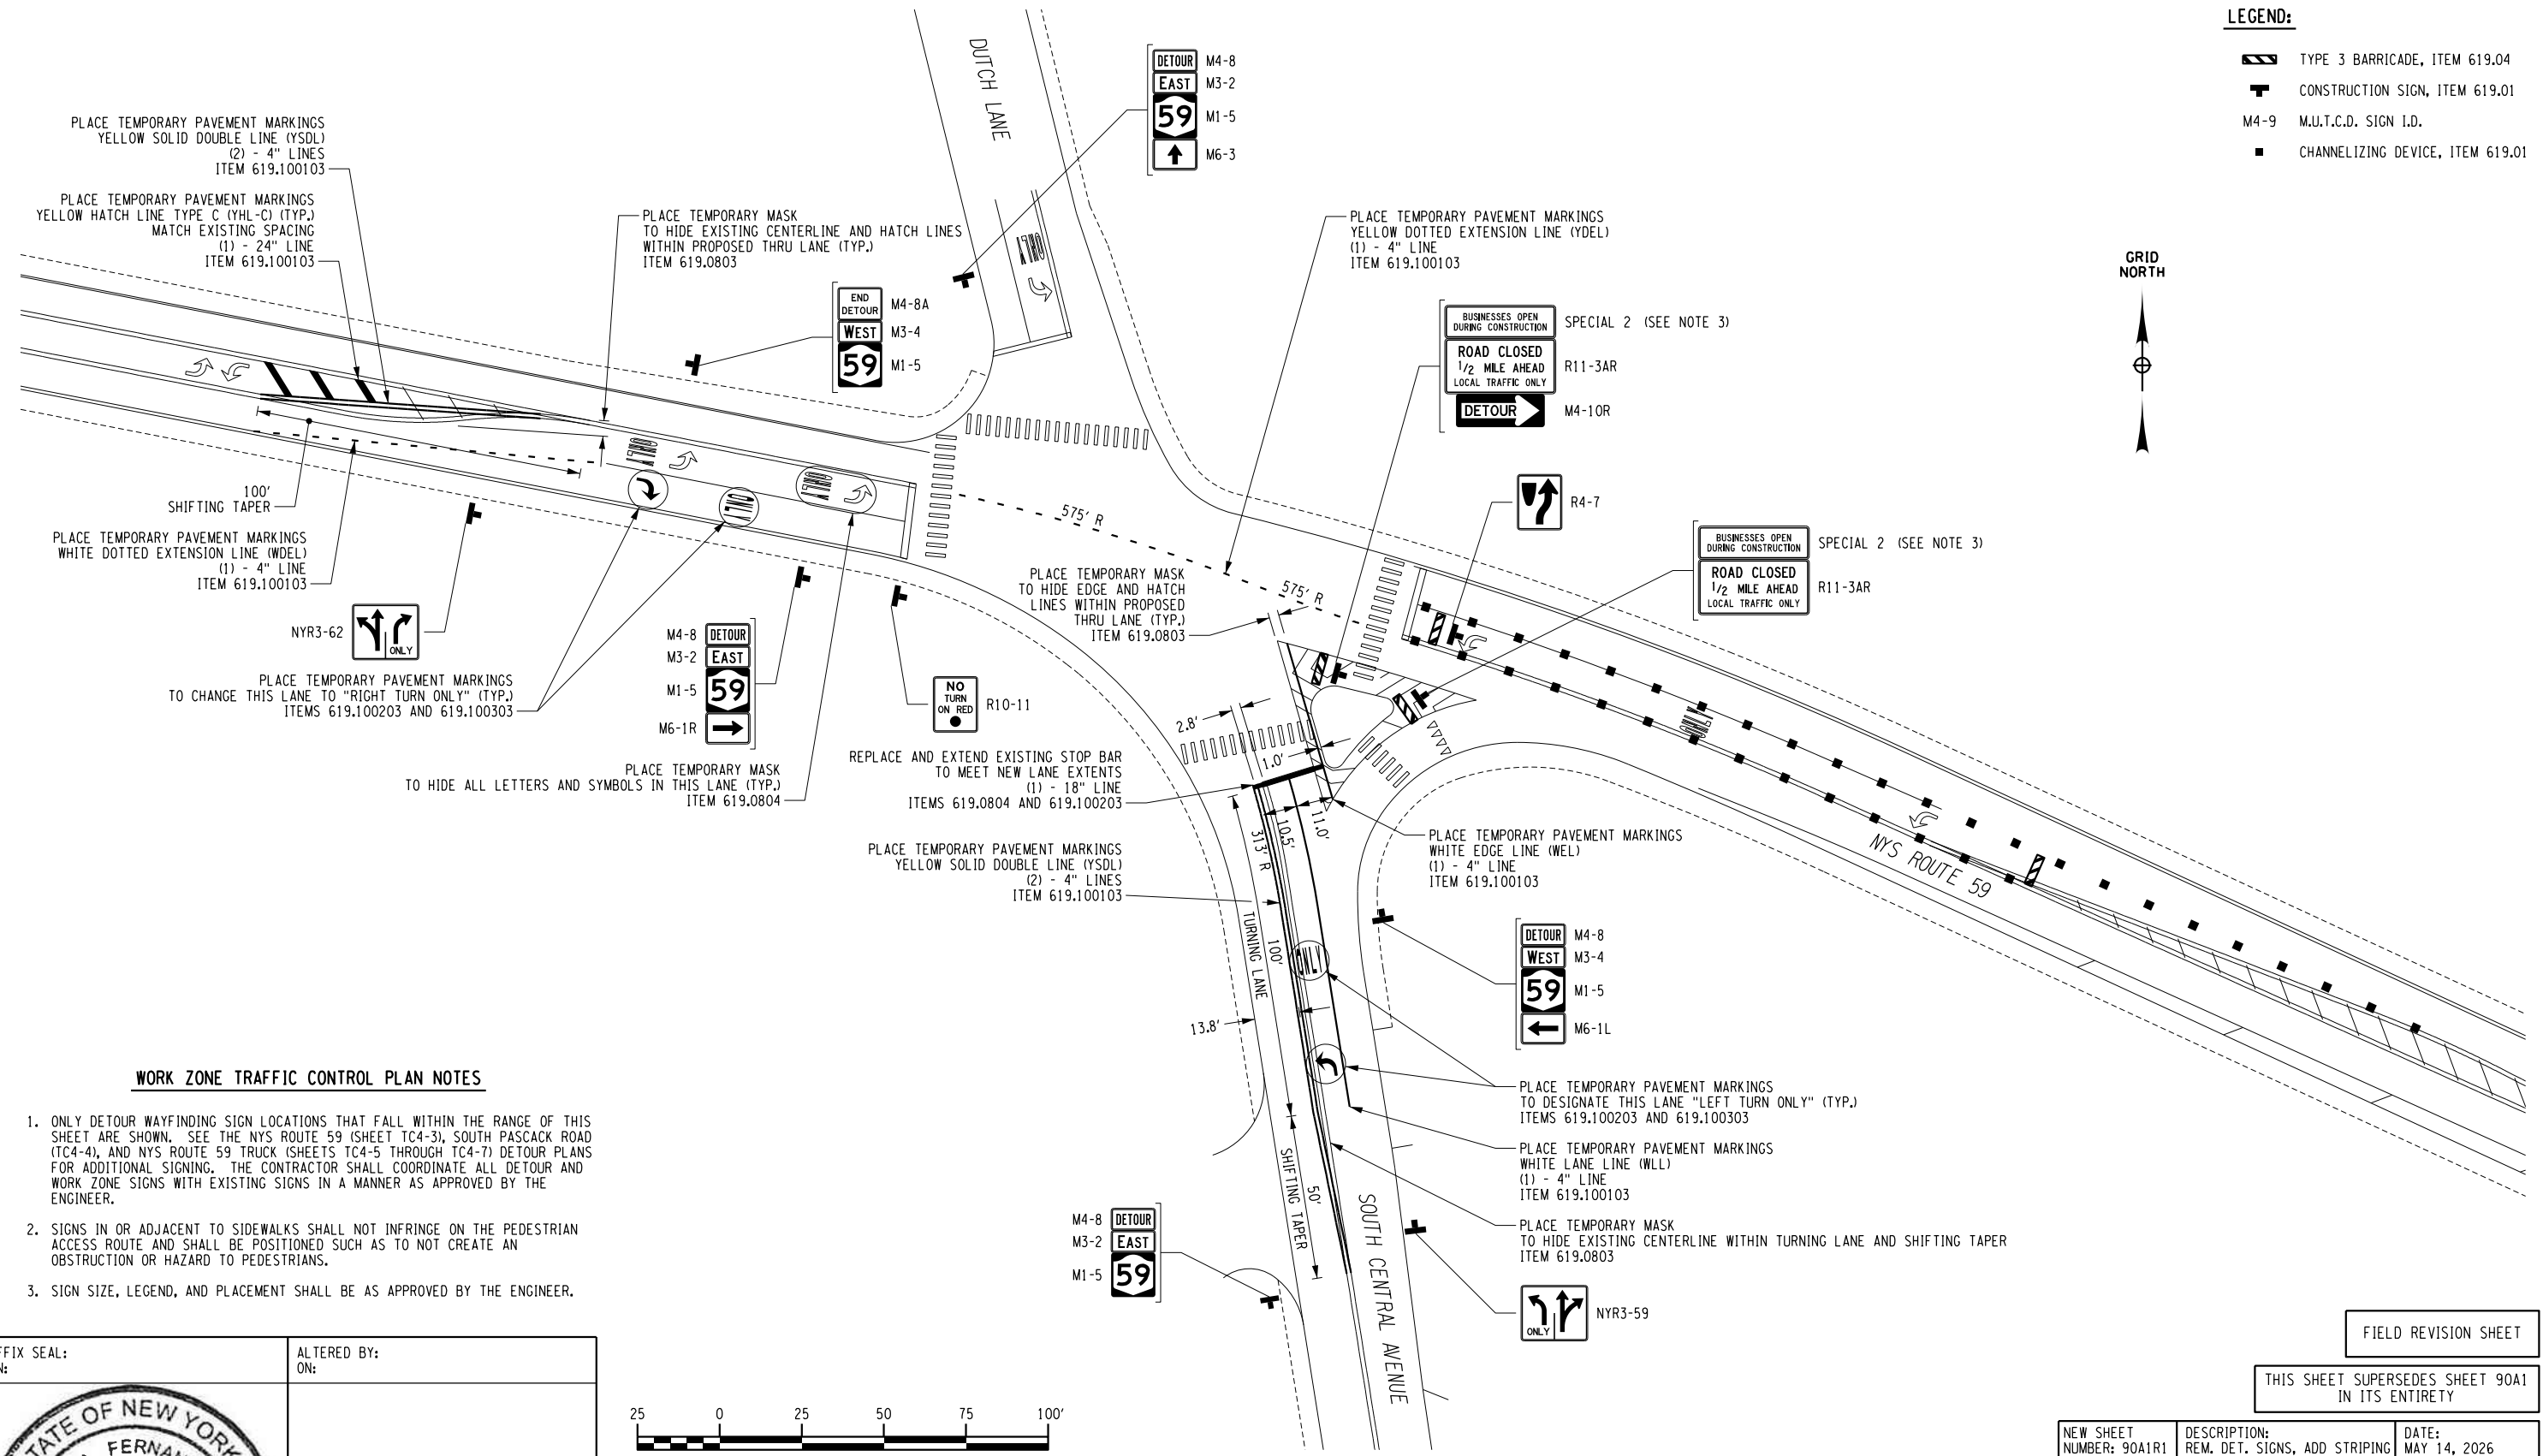


**WORK ZONE TRAFFIC CONTROL PLAN NOTES**

1. ONLY DETOUR WAYFINDING SIGN LOCATIONS THAT FALL WITHIN THE RANGE OF THIS SHEET ARE SHOWN. SEE THE NYS ROUTE 59 (SHEET TC4-3), SOUTH PASCACK ROAD (TC4-4), AND NYS ROUTE 59 TRUCK (SHEETS TC4-5 THROUGH TC4-7) DETOUR PLANS FOR ADDITIONAL SIGNING. THE CONTRACTOR SHALL COORDINATE ALL DETOUR AND WORK ZONE SIGNS WITH EXISTING SIGNS IN A MANNER AS APPROVED BY THE ENGINEER.
2. SIGNS IN OR ADJACENT TO SIDEWALKS SHALL NOT INFRINGE ON THE PEDESTRIAN ACCESS ROUTE AND SHALL BE POSITIONED SUCH AS TO NOT CREATE AN OBSTRUCTION OR HAZARD TO PEDESTRIANS.
3. SIGN SIZE, LEGEND, AND PLACEMENT SHALL BE AS APPROVED BY THE ENGINEER.

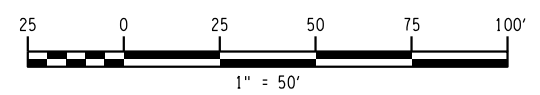

AFFIX SEAL:  
ON:

ALTERED BY:  
ON:



AS-BUILT REVISIONS DESCRIPTION OF ALTERATIONS:	NYSOT SUPERSTRUCTURE REPLACEMENT, ASSIGNMENT 6	PIN 8813.69	BRIDGES 1027670	CULVERTS	ALL DIMENSIONS IN FT UNLESS OTHERWISE NOTED	CONTRACT NUMBER D265445
	RT-59 OVER S. PASCACK ROAD				WORK ZONE TRAFFIC CONTROL PLAN (SHEET 3 OF 6)	DRAWING NO. TC4-10
	VILLAGE OF SPRING VALLEY AND TOWN OF CLARKSTOWN				(RT-59 OVER S. PASCACK ROAD)	SHEET NO. 90A1R1
	COUNTY: ROCKLAND REGION: 8					

IT IS A VIOLATION OF LAW FOR ANY PERSON, UNLESS THEY ARE ACTING UNDER THE DIRECTION OF A LICENSED PROFESSIONAL ENGINEER, ARCHITECT, LANDSCAPE ARCHITECT, OR LAND SURVEYOR, TO ALTER AN ITEM IN ANY WAY. IF AN ITEM BEARING THE STAMP OF A LICENSED PROFESSIONAL IS ALTERED, THE ALTERING ENGINEER, ARCHITECT, LANDSCAPE ARCHITECT, OR LAND SURVEYOR SHALL STAMP THE DOCUMENT AND INCLUDE THE NOTATION "ALTERED BY" FOLLOWED BY THEIR SIGNATURE, THE DATE OF SUCH ALTERATION, AND A SPECIFIC DESCRIPTION OF THE ALTERATION.

FIELD REVISION SHEET

THIS SHEET SUPERSEDES SHEET 90A1 IN ITS ENTIRETY

NEW SHEET NUMBER: 90A1R1	DESCRIPTION: REM. DET. SIGNS, ADD STRIPING	DATE: MAY 14, 2026
--------------------------	--	--------------------



FILE NAME = \$FILENAME\$  
 DATE/TIME = \$DATE\$  
 USER = \$USERNAME\$


PROJECT MANAGER L. FERNANDEZ  
 CHECK C. BIANCHI  
 DRAFTING C. SARGEANT  
 CHECK C. SARGEANT  
 DESIGN C. BIANCHI  
 JOB MANAGER L. FERNANDEZ  
 DESIGN SUPERVISOR B. SIVAKUMAR

**LEGEND:**

- TYPE 3 BARRICADE, ITEM 619.04
- CONSTRUCTION SIGN, ITEM 619.01
- M4-9 M.U.T.C.D. SIGN I.D.
- CHANNELIZING DEVICE, ITEM 619.01


**WORK ZONE TRAFFIC CONTROL PLAN NOTES**

1. ONLY DETOUR WAYFINDING SIGN LOCATIONS THAT FALL WITHIN THE RANGE OF THIS SHEET ARE SHOWN. SEE THE NYS ROUTE 59 (SHEET TC4-3), SOUTH PASCACK ROAD (TC4-4), AND NYS ROUTE 59 TRUCK (SHEETS TC4-5 THROUGH TC4-7) DETOUR PLANS FOR ADDITIONAL SIGNING. THE CONTRACTOR SHALL COORDINATE ALL DETOUR AND WORK ZONE SIGNS WITH EXISTING SIGNS IN A MANNER AS APPROVED BY THE ENGINEER.
2. SIGNS IN OR ADJACENT TO SIDEWALKS SHALL NOT INFRINGE ON THE PEDESTRIAN ACCESS ROUTE AND SHALL BE POSITIONED SUCH AS TO NOT CREATE AN OBSTRUCTION OR HAZARD TO PEDESTRIANS.
3. THE EXACT LAYOUT OF SIGN LOCATIONS SHOWING MULTIPLE SIGN PACKAGES SHALL BE DETERMINED IN THE FIELD AND NEED NOT BE ARRANGED VERTICALLY AS SHOWN ON THIS SHEET.

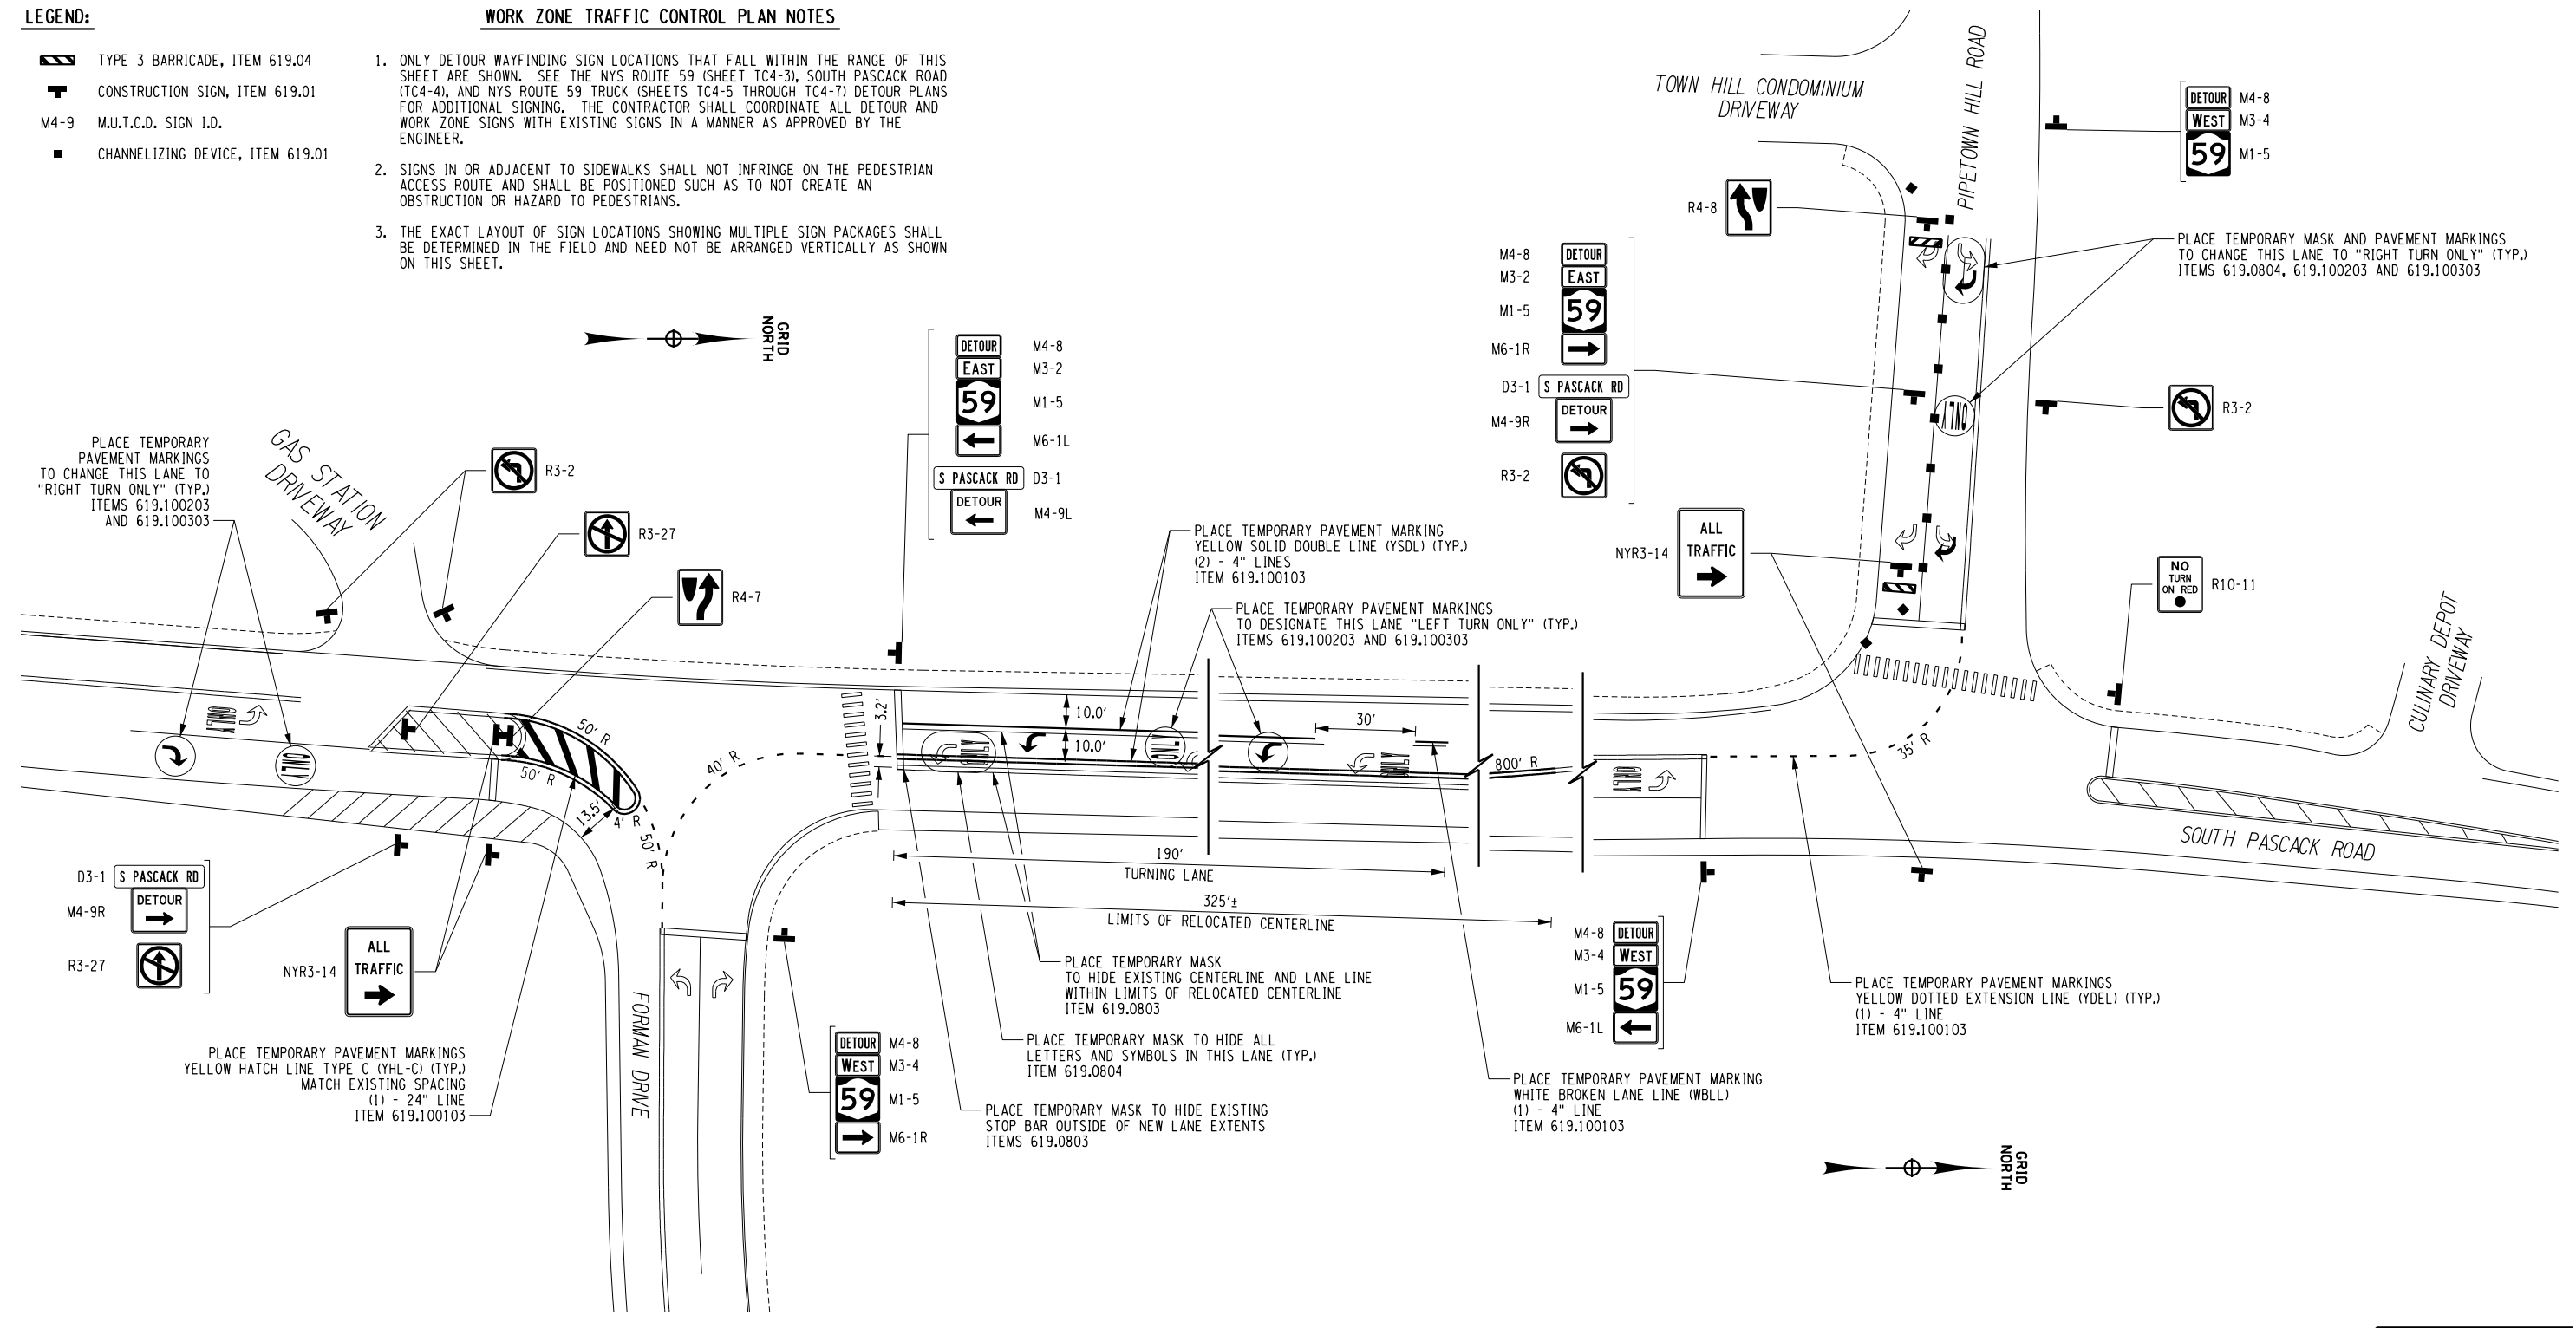

AFFIX SEAL:  
ON:

ALTERED BY:  
ON:

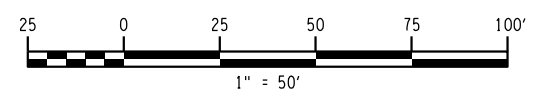

AS-BUILT REVISIONS DESCRIPTION OF ALTERATIONS:		NYSOT SUPERSTRUCTURE REPLACEMENT, ASSIGNMENT 6		PIN 8813.69		BRIDGES 1027670		CULVERTS		ALL DIMENSIONS IN FT UNLESS OTHERWISE NOTED		CONTRACT NUMBER D265445	
		RT-59 OVER S. PASCACK ROAD								WORK ZONE TRAFFIC CONTROL PLAN (SHEET 4 OF 6) (RT-59 OVER S. PASCACK ROAD)		DRAWING NO. TC4-11 SHEET NO. 90A2	
		VILLAGE OF SPRING VALLEY AND TOWN OF CLARKSTOWN											
		COUNTY: ROCKLAND		REGION: 8									
IT IS A VIOLATION OF LAW FOR ANY PERSON, UNLESS THEY ARE ACTING UNDER THE DIRECTION OF A LICENSED PROFESSIONAL ENGINEER, ARCHITECT, LANDSCAPE ARCHITECT, OR LAND SURVEYOR, TO ALTER AN ITEM IN ANY WAY. IF AN ITEM BEARING THE STAMP OF A LICENSED PROFESSIONAL IS ALTERED, THE ALTERING ENGINEER, ARCHITECT, LANDSCAPE ARCHITECT, OR LAND SURVEYOR SHALL STAMP THE DOCUMENT AND INCLUDE THE NOTATION "ALTERED BY" FOLLOWED BY THEIR SIGNATURE, THE DATE OF SUCH ALTERATION, AND A SPECIFIC DESCRIPTION OF THE ALTERATION.													

FIELD REVISION SHEET

THIS SHEET DOES NOT SUPERSEDE ANY SHEET

NEW SHEET NUMBER: 90A2	DESCRIPTION: NEW WZTC LOCATIONS	DATE: MAY 14, 2026
------------------------	---------------------------------	--------------------

FILE NAME = \$FILENAME\$  
 DATE/TIME = \$DATE\$  
 USER = \$USERNAME\$


PROJECT MANAGER L. FERNANDEZ  
 CHECK C. BIANCHI  
 DRAFTING C. SARGEANT  
 CHECK C. SARGEANT  
 DESIGN C. BIANCHI  
 JOB MANAGER L. FERNANDEZ  
 DESIGN SUPERVISOR B. SIVAKUMAR

**LEGEND:**


- CONSTRUCTION SIGN, ITEM 619.01
- M4-9 M.U.T.C.D. SIGN I.D.

**WORK ZONE TRAFFIC CONTROL PLAN NOTES**

1. ONLY DETOUR WAYFINDING SIGN LOCATIONS THAT FALL WITHIN THE RANGE OF THIS SHEET ARE SHOWN. SEE THE NYS ROUTE 59 (SHEET TC4-3), SOUTH PASCACK ROAD (TC4-4), AND NYS ROUTE 59 TRUCK (SHEETS TC4-5 THROUGH TC4-7) DETOUR PLANS FOR ADDITIONAL SIGNING. THE CONTRACTOR SHALL COORDINATE ALL DETOUR AND WORK ZONE SIGNS WITH EXISTING SIGNS IN A MANNER AS APPROVED BY THE ENGINEER.
2. SIGNS IN OR ADJACENT TO SIDEWALKS SHALL NOT INFRINGE ON THE PEDESTRIAN ACCESS ROUTE AND SHALL BE POSITIONED SUCH AS TO NOT CREATE AN OBSTRUCTION OR HAZARD TO PEDESTRIANS.
3. THE EXACT LAYOUT OF SIGN LOCATIONS SHOWING MULTIPLE SIGN PACKAGES SHALL BE DETERMINED IN THE FIELD AND NEED NOT BE ARRANGED VERTICALLY AS SHOWN ON THIS SHEET.
4. THE TOTAL LENGTH OF PARKING RESTRICTIONS ON EITHER SIDE OF SOUTH CENTRAL AVENUE SHALL BE APPROXIMATELY 200 FEET, BEGINNING AT THE INTERSECTION WITH PIPETOWN HILL ROAD AND HEADING NORTH. THE PARKING RESTRICTION SIGNS WILL BE INSTALLED BY OTHERS.

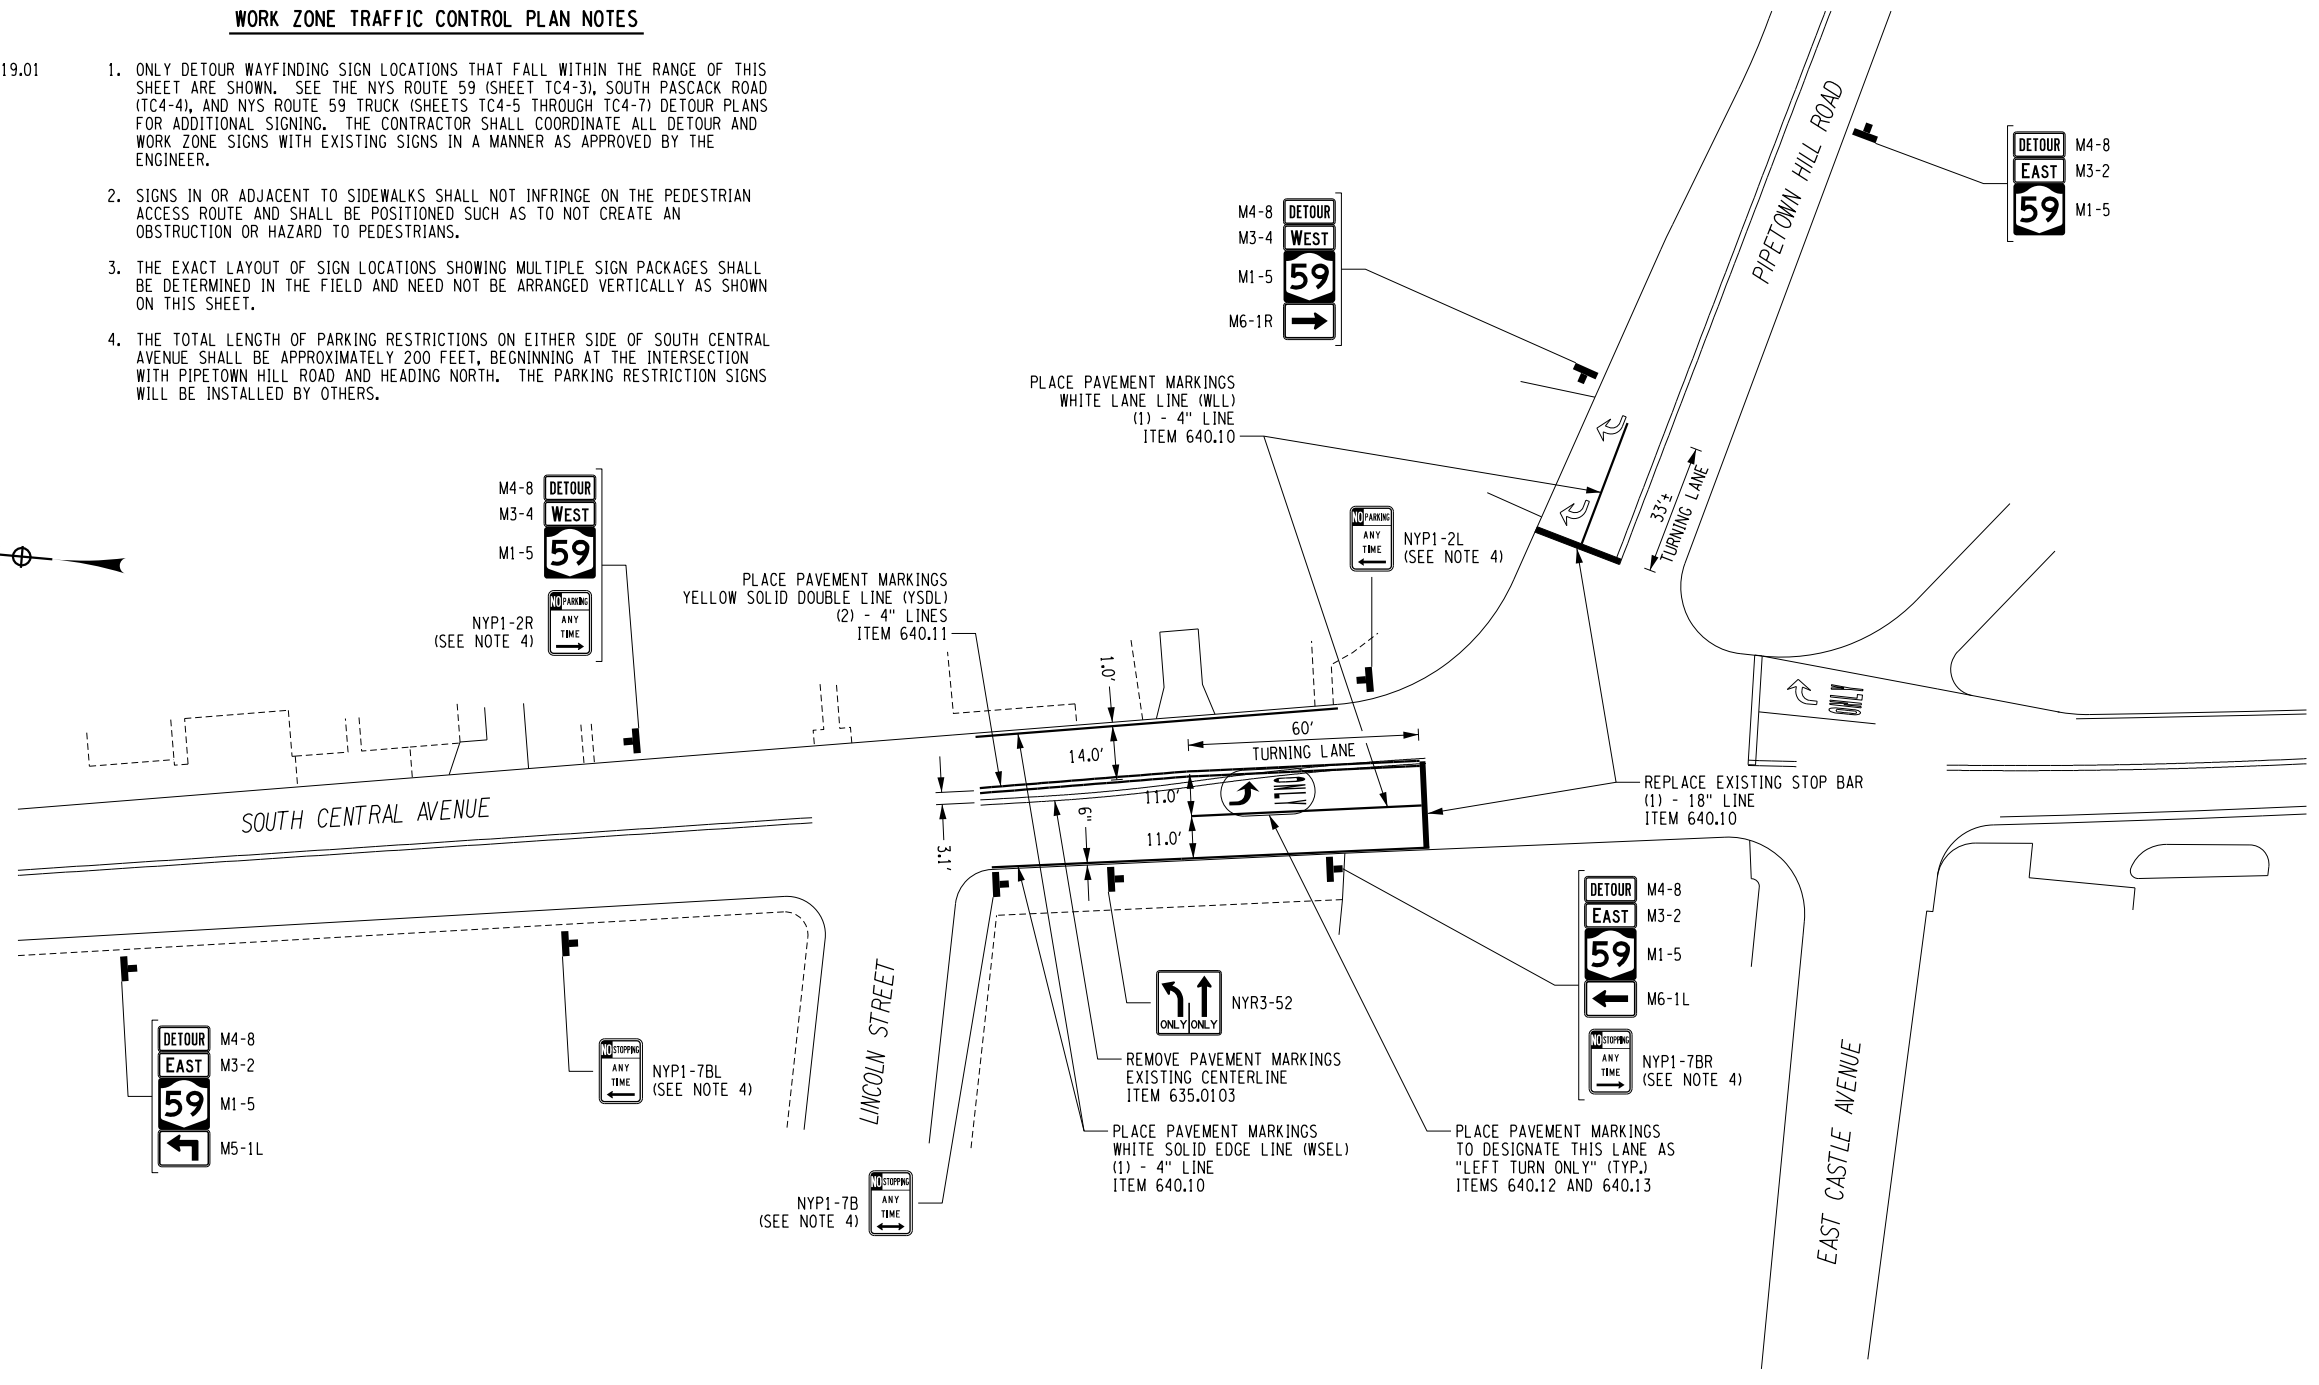

AFFIX SEAL: ON: \_\_\_\_\_  
 ALTERED BY: ON: \_\_\_\_\_

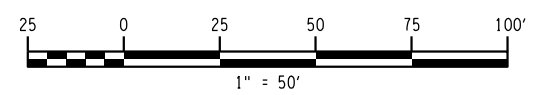

AS-BUILT REVISIONS DESCRIPTION OF ALTERATIONS:	NYSOT SUPERSTRUCTURE REPLACEMENT, ASSIGNMENT 6	PIN 8813.69	BRIDGES 1027670	CULVERTS
	RT-59 OVER S. PASCACK ROAD			
	VILLAGE OF SPRING VALLEY AND TOWN OF CLARKSTOWN			
	COUNTY: ROCKLAND REGION: 8			

IT IS A VIOLATION OF LAW FOR ANY PERSON, UNLESS THEY ARE ACTING UNDER THE DIRECTION OF A LICENSED PROFESSIONAL ENGINEER, ARCHITECT, LANDSCAPE ARCHITECT, OR LAND SURVEYOR, TO ALTER AN ITEM IN ANY WAY. IF AN ITEM BEARING THE STAMP OF A LICENSED PROFESSIONAL IS ALTERED, THE ALTERING ENGINEER, ARCHITECT, LANDSCAPE ARCHITECT, OR LAND SURVEYOR SHALL STAMP THE DOCUMENT AND INCLUDE THE NOTATION "ALTERED BY" FOLLOWED BY THEIR SIGNATURE, THE DATE OF SUCH ALTERATION, AND A SPECIFIC DESCRIPTION OF THE ALTERATION.

FIELD REVISION SHEET  
 THIS SHEET DOES NOT SUPERSEDE ANY SHEET

NEW SHEET NUMBER: 90A3	DESCRIPTION: NEW WZTC LOCATION	DATE: MAY 14, 2026
---------------------------	-----------------------------------	-----------------------

ALL DIMENSIONS IN FT UNLESS OTHERWISE NOTED	CONTRACT NUMBER D265445
WORK ZONE TRAFFIC CONTROL PLAN (SHEET 5 OF 6) (RT-59 OVER S. PASCACK ROAD)	DRAWING NO. TC4-12 SHEET NO. 90A3



FILE NAME = \$FILENAME\$  
 DATE/TIME = \$DATE\$  
 USER = \$USERNAME\$




PROJECT MANAGER L. FERNANDEZ  
 CHECK C. BIANCHI  
 DRAFTING C. SARGEANT  
 CHECK C. SARGEANT  
 DESIGN C. BIANCHI  
 JOB MANAGER L. FERNANDEZ  
 DESIGN SUPERVISOR B. SIVAKUMAR


FILE NAME = \$FILENAME\$  
 DATE/TIME = \$DATE\$  
 USER = \$USERNAME\$

**WORK ZONE TRAFFIC CONTROL PLAN NOTES**

1. ONLY DETOUR AND WORK ZONE TRAFFIC CONTROL SIGN LOCATIONS THAT FALL WITHIN THE RANGE OF THIS SHEET ARE SHOWN. SEE THE NYS ROUTE 59 (SHEET TC4-3), SOUTH PASCACK ROAD (TC4-4), AND NYS ROUTE 59 TRUCK (SHEETS TC4-5 THROUGH TC4-7) DETOUR PLANS AS WELL AS THE WORK ZONE TRAFFIC CONTROL PLANS (SHEETS TC4-8 THROUGH TC4-12) FOR ADDITIONAL SIGNING. THE CONTRACTOR SHALL COORDINATE ALL DETOUR AND WORK ZONE SIGNS WITH EXISTING SIGNS IN A MANNER AS APPROVED BY THE ENGINEER.
2. DETOUR AND WORK ZONE SIGNS LOCATIONS NOT SPECIFIC TO FLAGGING OPERATIONS ARE MARKED WITH AN ASTERISK (\*). THESE SIGNS SHALL REMAIN IN PLACE DURING AND AFTER FLAGGING OPERATIONS ARE COMPLETED.
3. THE TRAFFIC SIGNAL NO. 63 AT SOUTH PASCACK ROAD AND PIPETOWN HILL ROAD SHALL BE DEACTIVATED DURING FLAGGING OPERATIONS.
4. THE EXACT LAYOUT OF SIGN LOCATIONS SHOWING MULTIPLE SIGN PACKAGES SHALL BE DETERMINED IN THE FIELD AND NEED NOT BE ARRANGED VERTICALLY AS SHOWN ON THIS SHEET.

**LEGEND:**

-  TYPE 3 BARRICADE, ITEM 619.04
-  CONSTRUCTION SIGN, ITEM 619.01
- M4-9 M.U.T.C.D. SIGN I.D.
-  CHANNELIZING DEVICE, ITEM 619.01

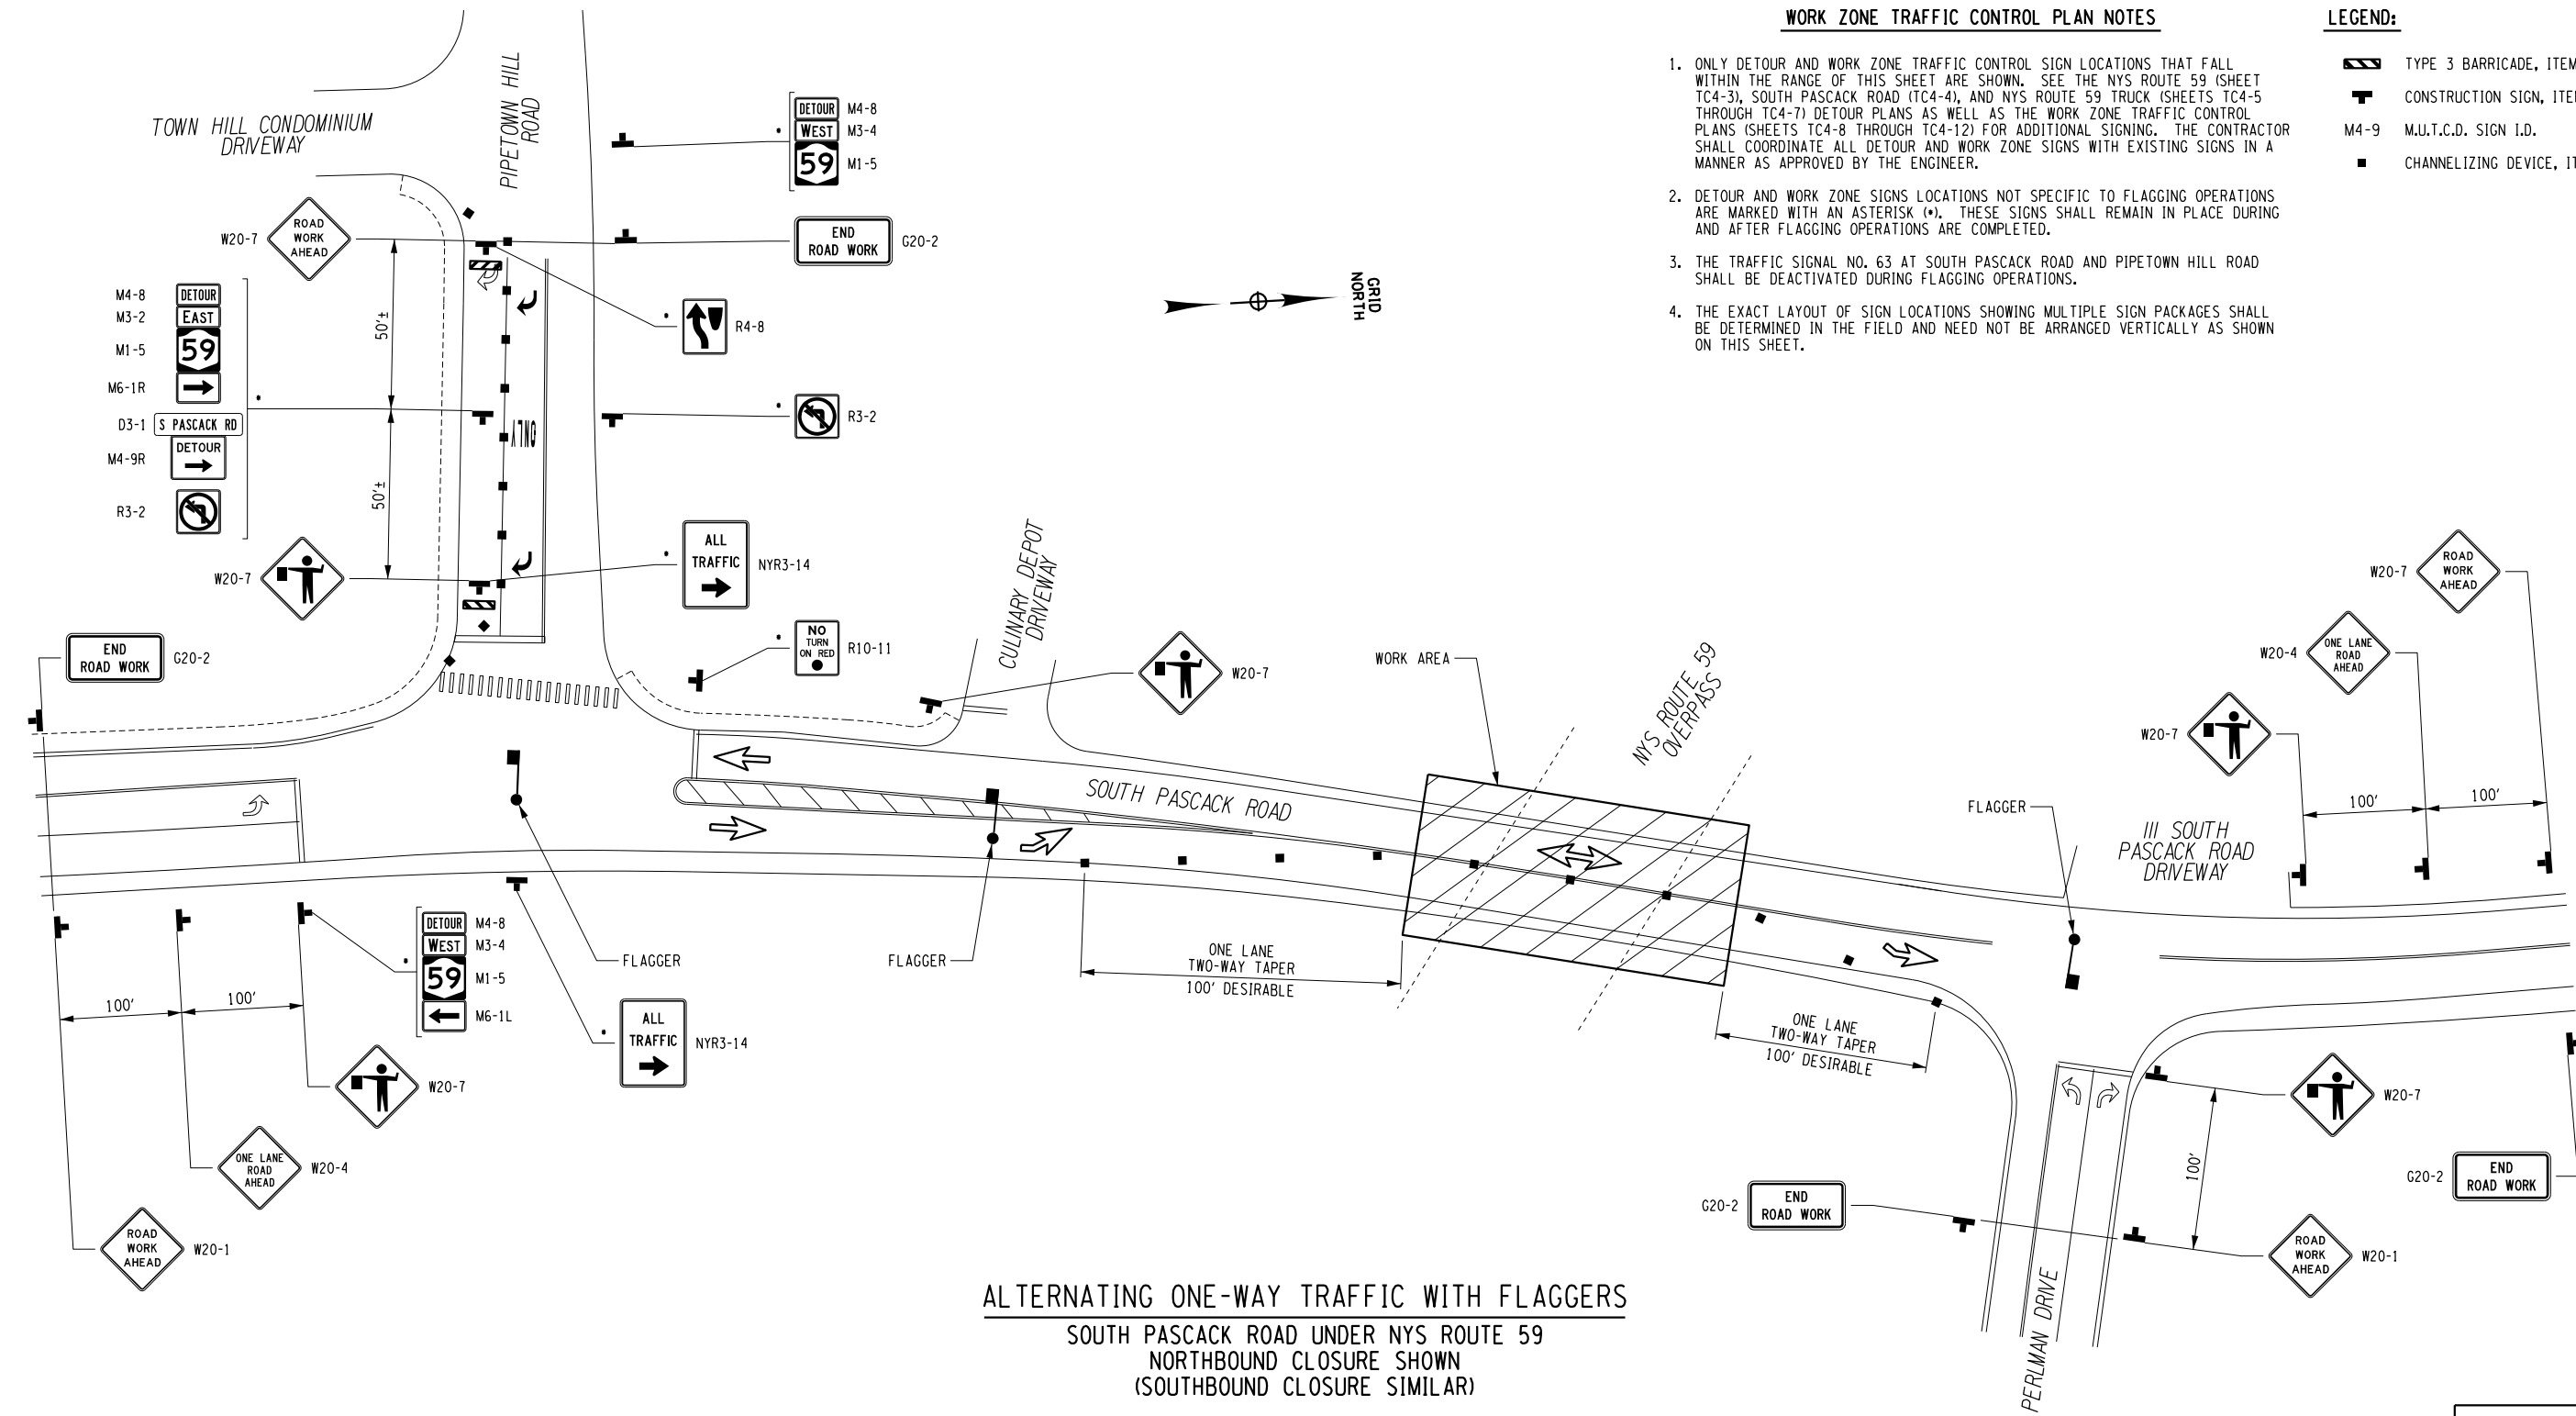


**ALTERNATING ONE-WAY TRAFFIC WITH FLAGGERS**  
 SOUTH PASCACK ROAD UNDER NYS ROUTE 59  
 NORTHBOUND CLOSURE SHOWN  
 (SOUTHBOUND CLOSURE SIMILAR)

FIELD REVISION SHEET

THIS SHEET SUPERSEDES SHEET 91A1 IN ITS ENTIRETY

NEW SHEET NUMBER: 91A1R1	DESCRIPTION: ADDED FLAGGER LOCATION	DATE: MAY 14, 2026
--------------------------	-------------------------------------	--------------------

AFFIX SEAL: ON: 

ALTERED BY: ON:

AS-BUILT REVISIONS DESCRIPTION OF ALTERATIONS:	NYS DOT SUPERSTRUCTURE REPLACEMENT, ASSIGNMENT 6	PIN 8813.69	BRIDGES 1027670	CULVERTS	ALL DIMENSIONS IN FT UNLESS OTHERWISE NOTED	CONTRACT NUMBER D265445
	RT-59 OVER S. PASCACK ROAD					WORK ZONE TRAFFIC CONTROL PLAN (SHEET 6 OF 6)
	VILLAGE OF SPRING VALLEY AND TOWN OF CLARKSTOWN				WORK ZONE TRAFFIC CONTROL PLAN (SHEET 6 OF 6)	SHEET NO. 91A1R1
	COUNTY: ROCKLAND REGION: 8					

IT IS A VIOLATION OF LAW FOR ANY PERSON, UNLESS THEY ARE ACTING UNDER THE DIRECTION OF A LICENSED PROFESSIONAL ENGINEER, ARCHITECT, LANDSCAPE ARCHITECT, OR LAND SURVEYOR, TO ALTER AN ITEM IN ANY WAY. IF AN ITEM BEARING THE STAMP OF A LICENSED PROFESSIONAL IS ALTERED, THE ALTERING ENGINEER, ARCHITECT, LANDSCAPE ARCHITECT, OR LAND SURVEYOR SHALL STAMP THE DOCUMENT AND INCLUDE THE NOTATION "ALTERED BY" FOLLOWED BY THEIR SIGNATURE, THE DATE OF SUCH ALTERATION, AND A SPECIFIC DESCRIPTION OF THE ALTERATION.

